Attachment 5

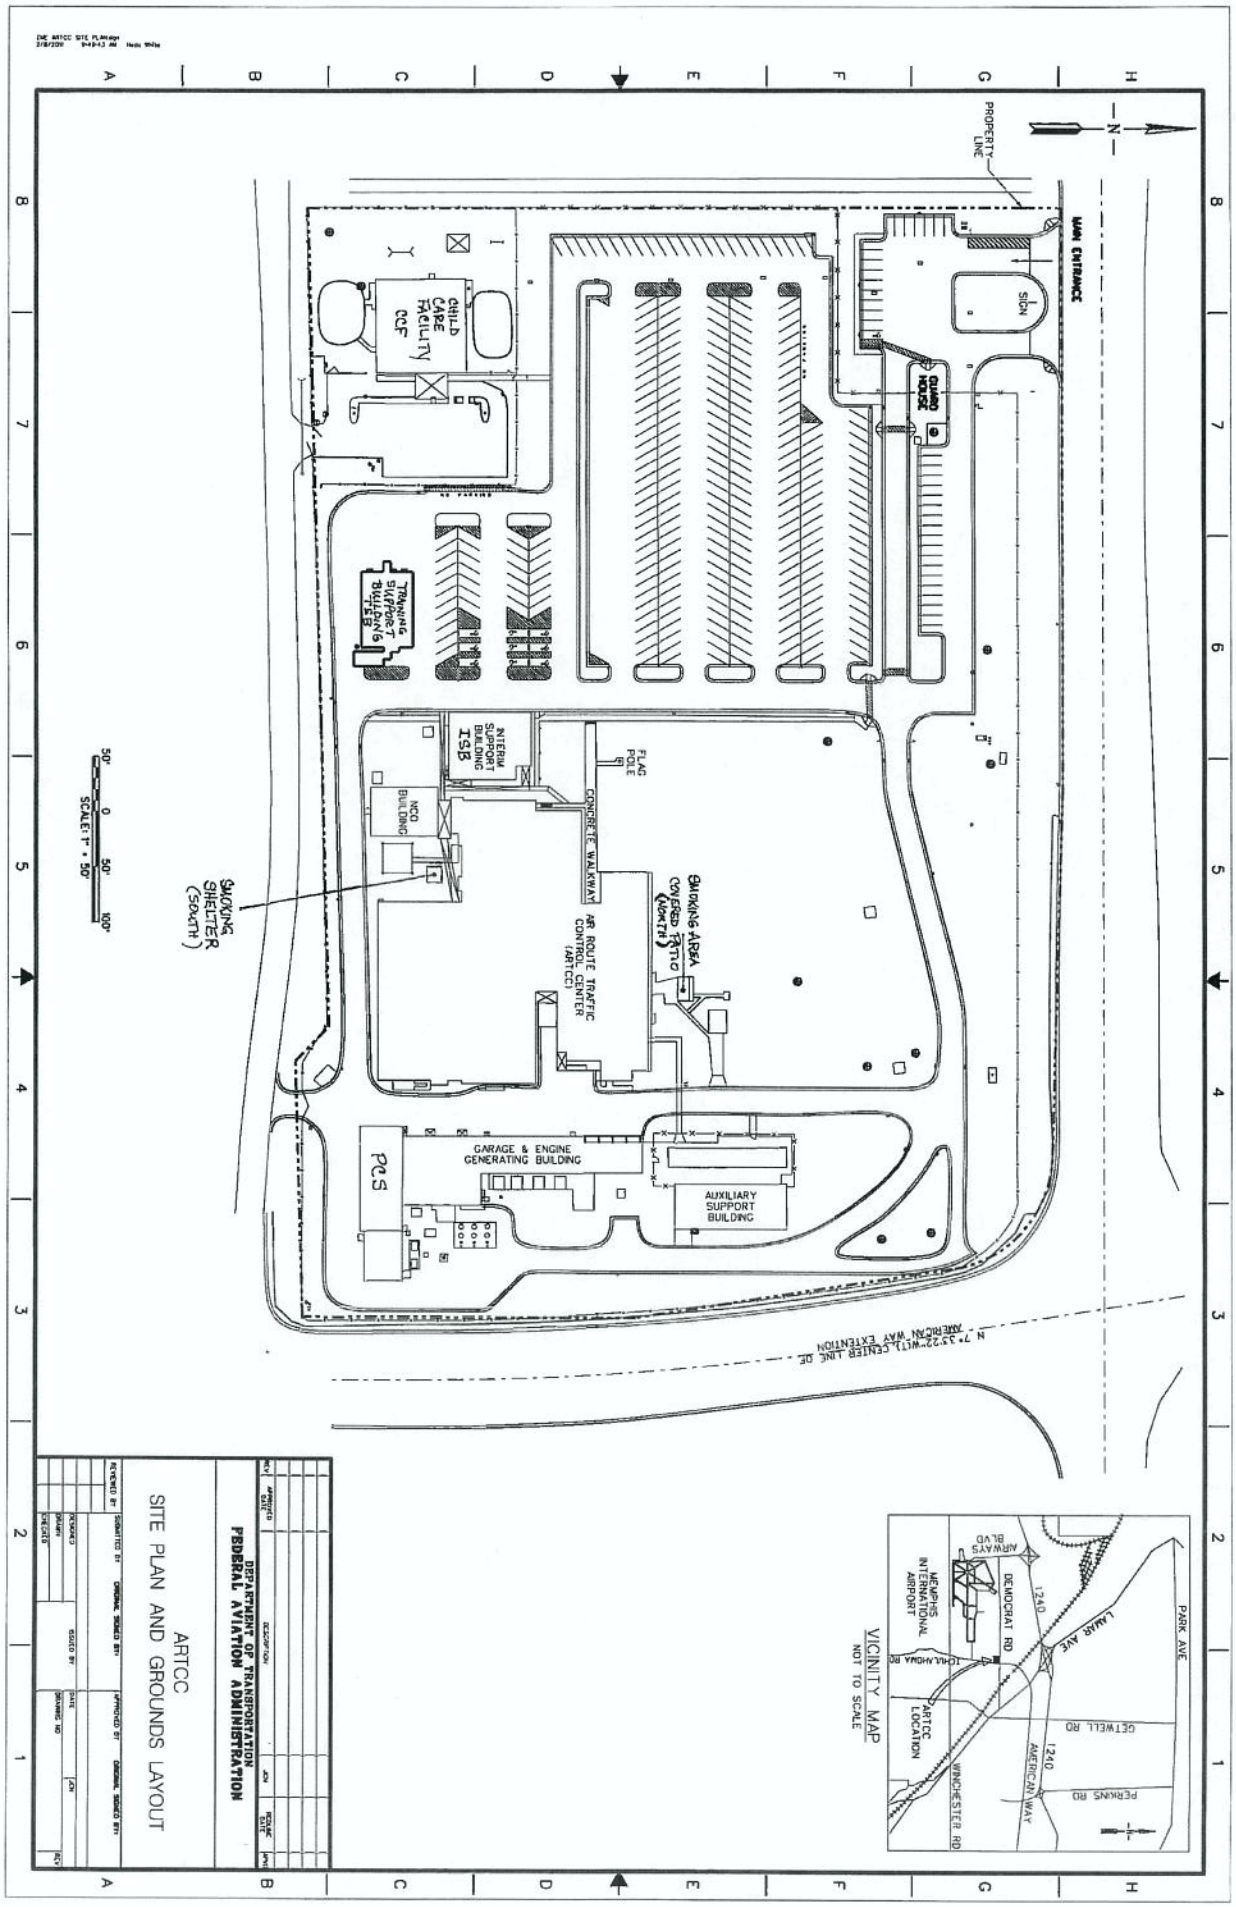

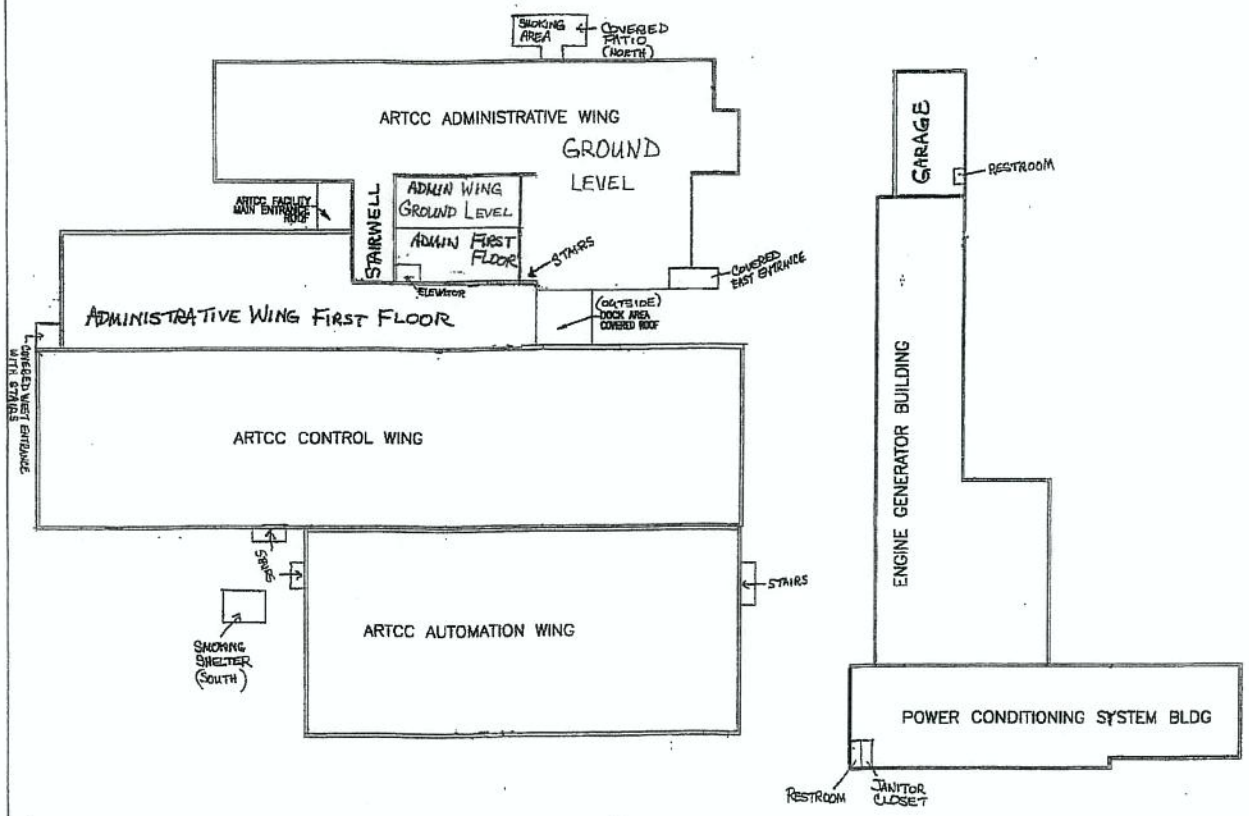

B				
A				
SCHEM.	SHT.	DESCRIPTION	CHECKED	APPROVED

DEPARTMENT OF TRANSPORTATION
FEDERAL AVIATION ADMINISTRATION

AIR ROUTE TRAFFIC CONTROL CENTER
3229 DEMOCRAT ROAD
MEMPHIS, TENNESSEE
(ARTCC BASELINE)

TN

B

DESIGNATION	DESCRIPTION	FLOOR AREA	FLOOR
100	CLASSROOM	385	CARPET
101	OPEN OFFICE	520	CARPET
102	OFFICE	139	CARPET
103	STORAGE	152	TILE
104	TELCOM/ ELECTRICAL	50	TILE
105	HALLWAY	437	TILE
106	CLASSROOM	456	CARPET
107	CLASSROOM	456	CARPET
108	MEN'S RR	137	TILE
109	WOMEN'S RR	137	TILE
110	JANITOR	27	TILE

DOOR SCHEDULE

DESIGNATION	SIZE	DOOR MATERIAL	FRAME	RO	QTY
D1	3068R	STEEL W/ LG VISION GLASS	STEEL	40½" X 82½"	1
D2	3068L	STEEL W/ LG VISION GLASS	STEEL	40½" X 82½"	1
D3	3068L	MOHAWK SOLID CORE W/ VISION GLASS	STEEL	37 ½" X 81 ½"	4
D4	3068R	MOHAWK SOLID CORE W/ VISON GLASS	STEEL	37 ½" X 81 ½"	3
D5	3068R	1-3/4" SC MOHAWK	STEEL	37 ½" X 81 ½"	2
D6	3068L	1-3/4" SC MOHAWK	STEEL	37 ½" X 81 ½"	1

WINDOW SCHEDULE

DESIGNATION	DESCRIPTION	RO	QTY
W1	2040 VINYL V.S., DOUBLE INSULATED LOW E GLASS W/ ALUMINUM MINI BLINDS	24½" X 48½"	14
W2	2030 VINYL V.S., DOUBLE INSULATED LOW E GLASS W/ SG - OBSCURE	24½" X 36½"	2

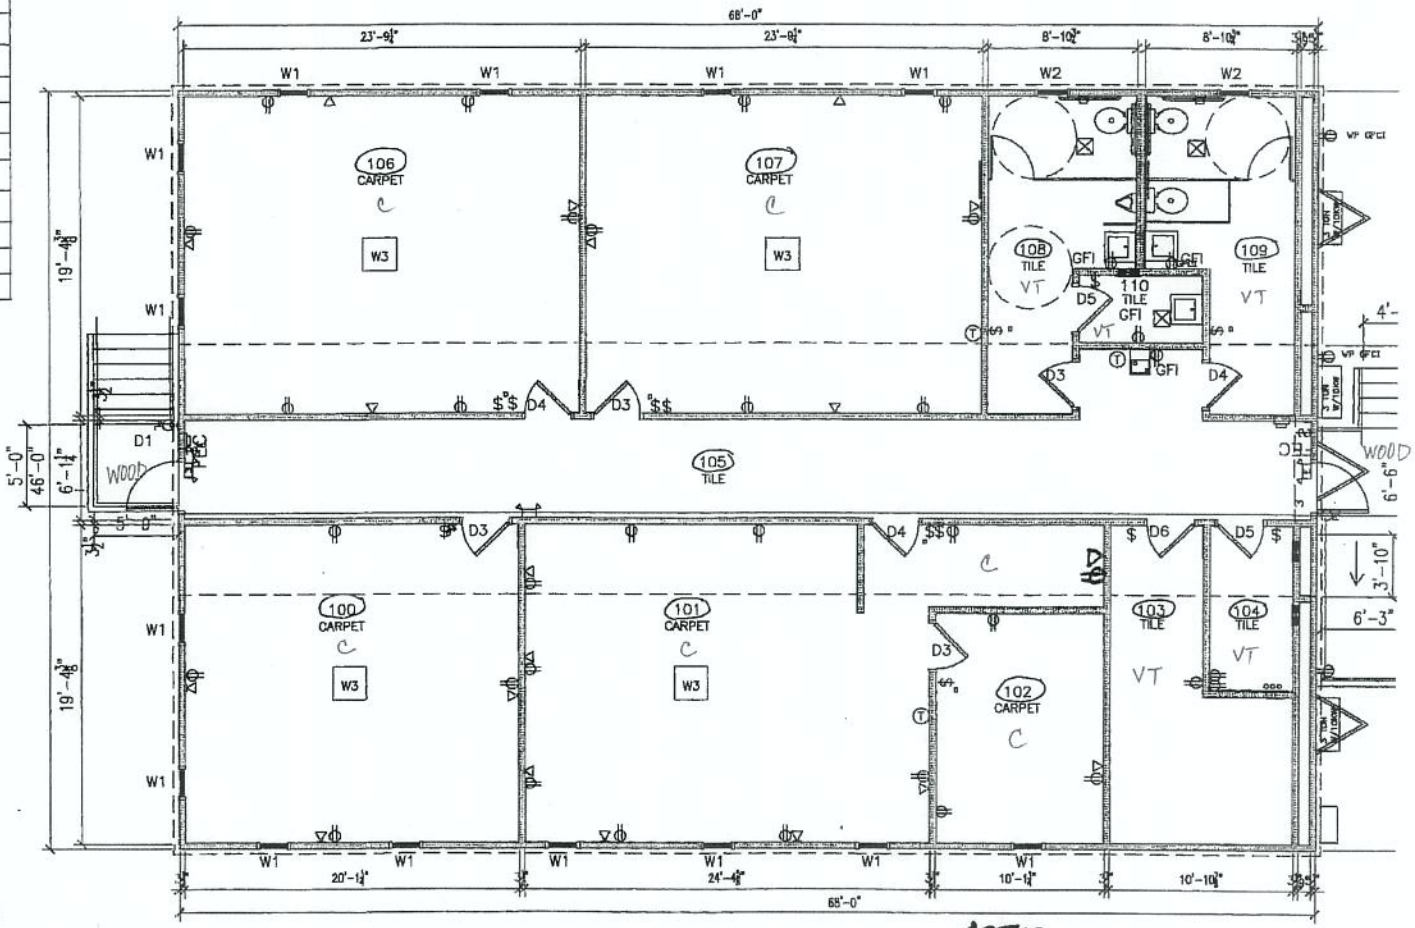

FLOORING:
C = CARPET
VT = VINYL TILE

ARTCC
TRAINING SUPPORT BLDG
(TSB)
MEMPHIS TN

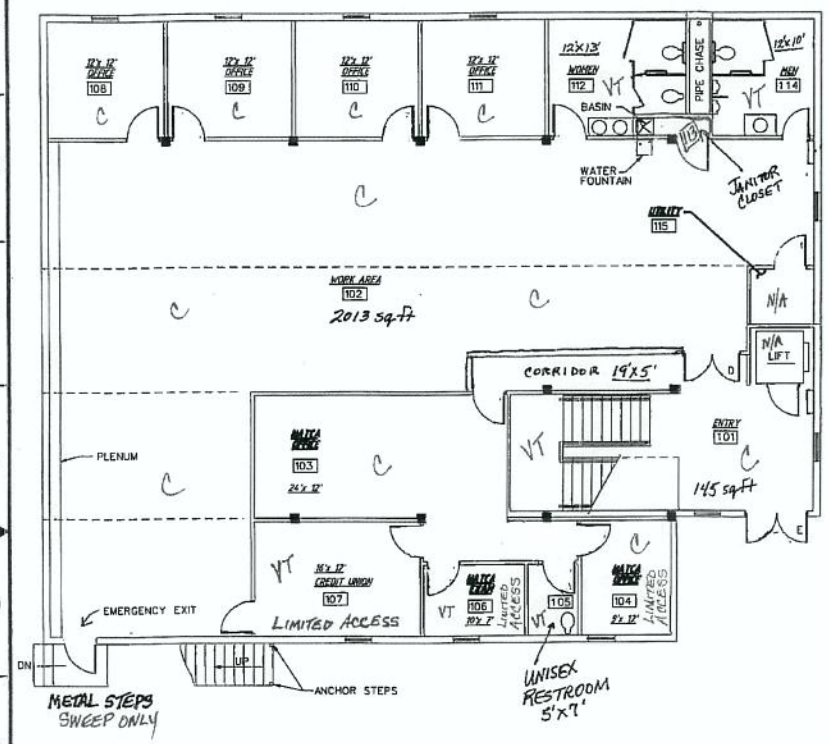

1 Q20 FIRST FLOOR PLAN

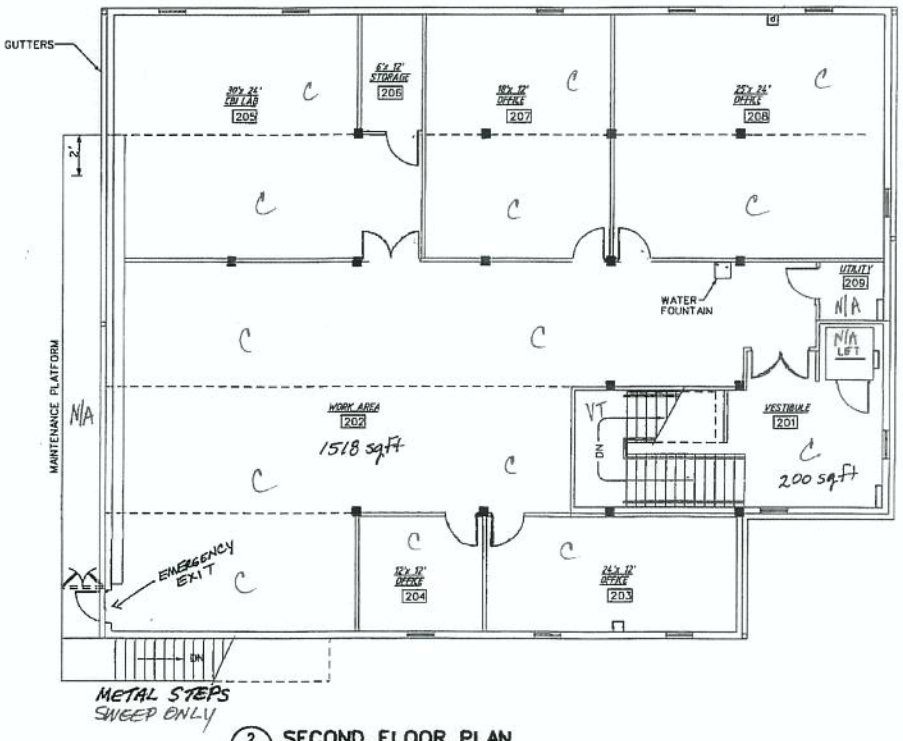

2 Q20 SECOND FLOOR PLAN

FLOORING:
VT = VINYL TILE
C = CARPET
N/A = NOT APPLICABLE - NO SERVICE

REV	APPROVED DATE	DESCRIPTION	JCN	RELEASE DATE	APVD

DEPARTMENT OF TRANSPORTATION
FEDERAL AVIATION ADMINISTRATION

ARTCC
INTERIUM SUPPORT BUILDING
(ISB)

MEMPHIS TN

REVIEWED BY	SUBMITTED BY	APPROVED BY
	RECOMMD	ISSUED BY
	DRAWN	DATE
	CHECKED	DRAWING NO

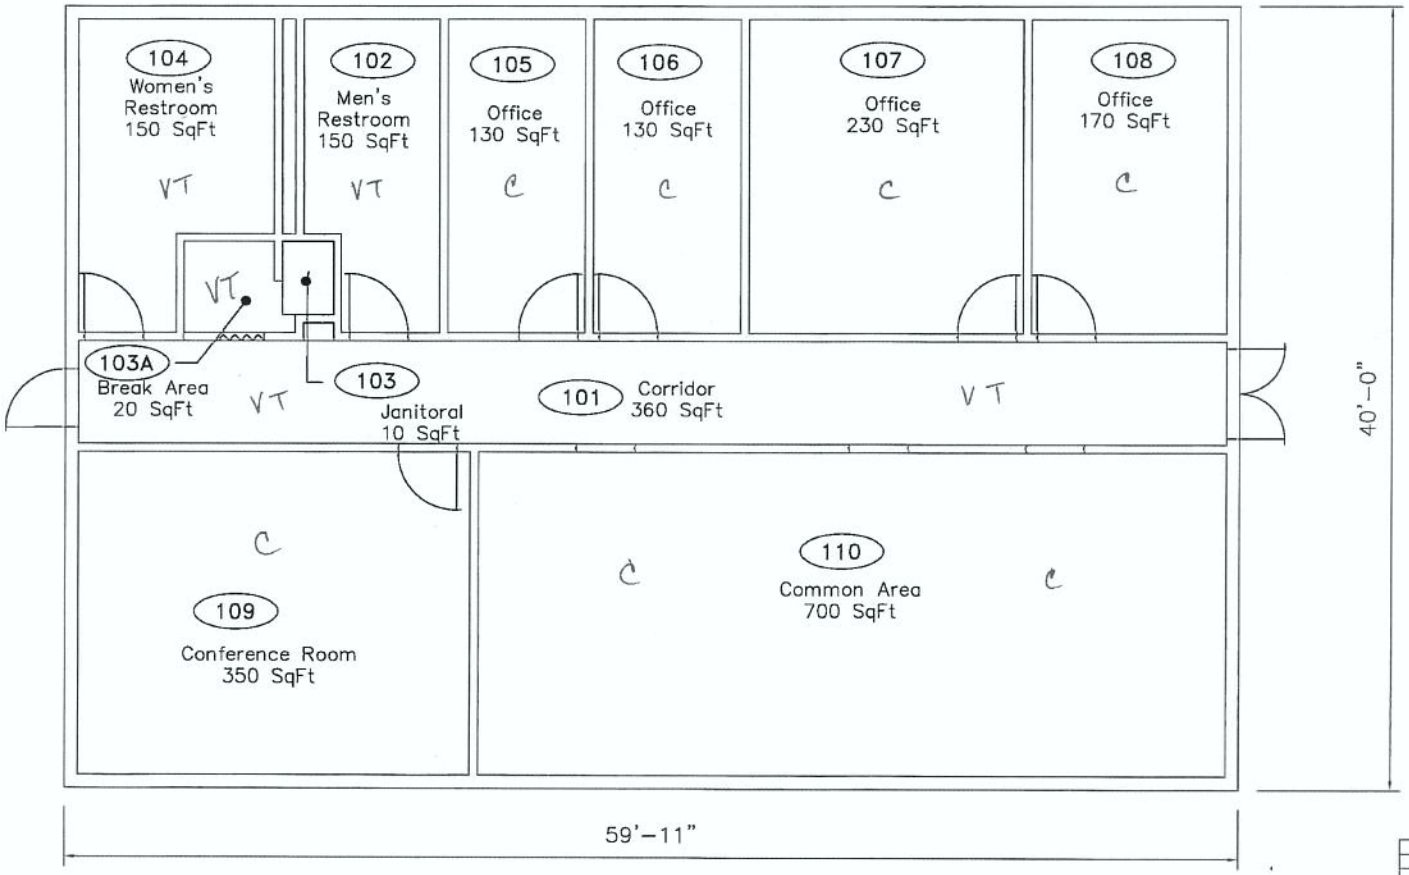

FLOORING:
VT = VINYL TILE
C = CARPET

MEMPHIS NAS COORDINATION OFFICE BUILDING
MEMPHIS ARTCC

NCO

MEMPHIS TN

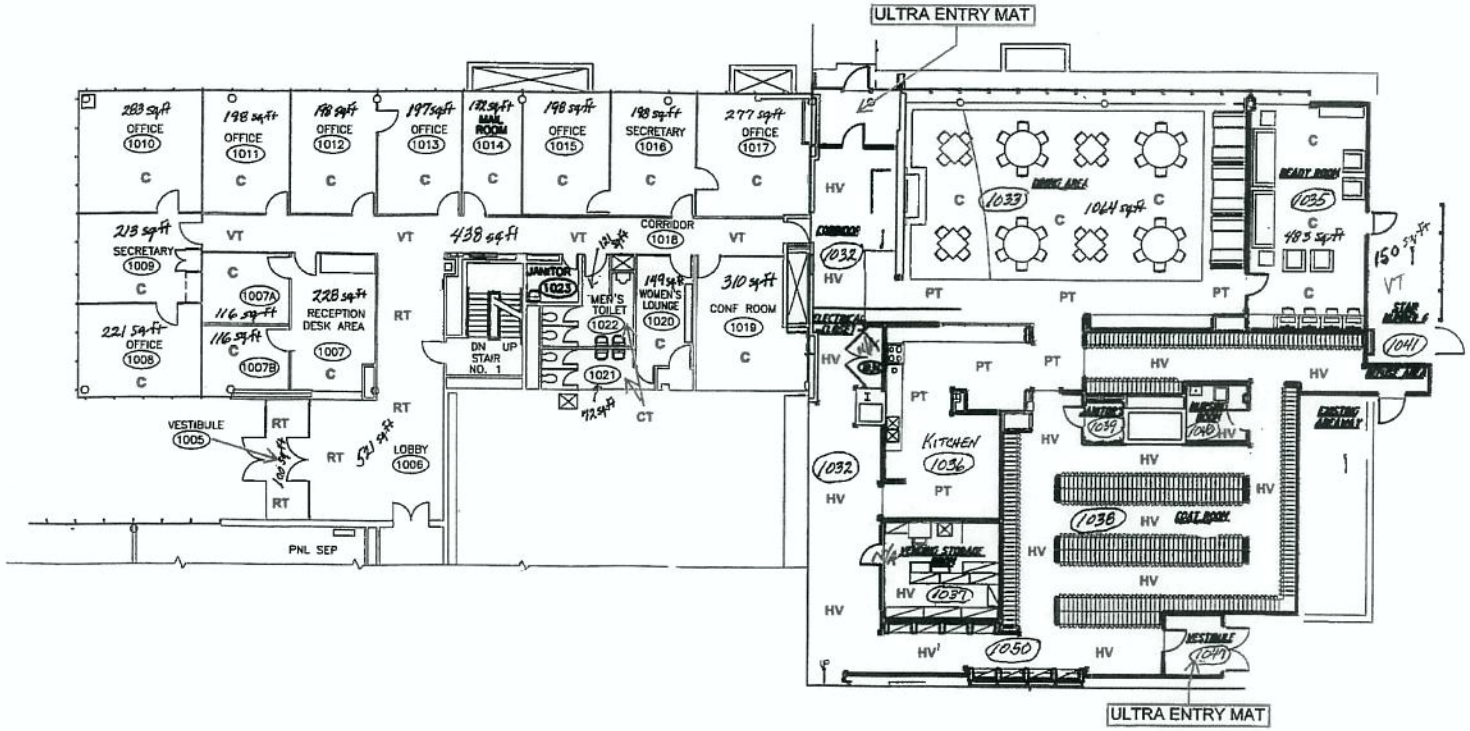

TYPES OF FLOORING:

	TOTAL SQUARE FEET:
RT = RED BRICK TILE	621 SF
HV = HETEROGENEOUS VINYL	1,770 SF
CT = CERAMIC TILE	204 SF
PT = PORCELAIN UNGLAZED TILE	641 SF
VT = VINYL TILE	400 SF
C = CARPET (DINING AND READY ROOM)	1,900 SF
C = CARPET (ADMIN OFFICES)	2,627 SF

N/A = NOT APPLICABLE - NO SERVICE

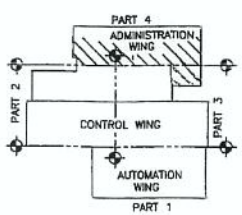

KEY PLAN

REV	APPROVED DATE	DESCRIPTION	JCN	REQUIRE DATE	APVD
E	08/10/2010	AS-BUILT PER CCD #31515 N 31977 (Y.W) M	MEMARTC	06/02/2008	
D		PER AS-BUILT	AJW	08/18/1999	JLK
C		PER CCD 20514	DWD	05/26/1998	JLK
B		PER CCD 19728	AJW	08/01/1997	JLK

DEPARTMENT OF TRANSPORTATION
FEDERAL AVIATION ADMINISTRATION
SOUTHERN REGION ATLANTA, GA

ARTCC
ADMINISTRATIVE WING GROUND LEVEL

MEMPHIS MEMPHIS CENTER TN

REVIEWED BY

SUBMITTED BY: Hedo J. White
NAS ONSITE COORD, ASO-459
DESIGNED RAH
DRAWN WJS
CHECKED WJS
ISSUED BY ARWAY FACILITIES ASO-400

APPROVED BY: James L. Nelson
MGR PROG/ENVIRO BR, ASO-471
DATE 12/31/1991
JCN
DRAWING NO SO-D-101713-008
REV E

S

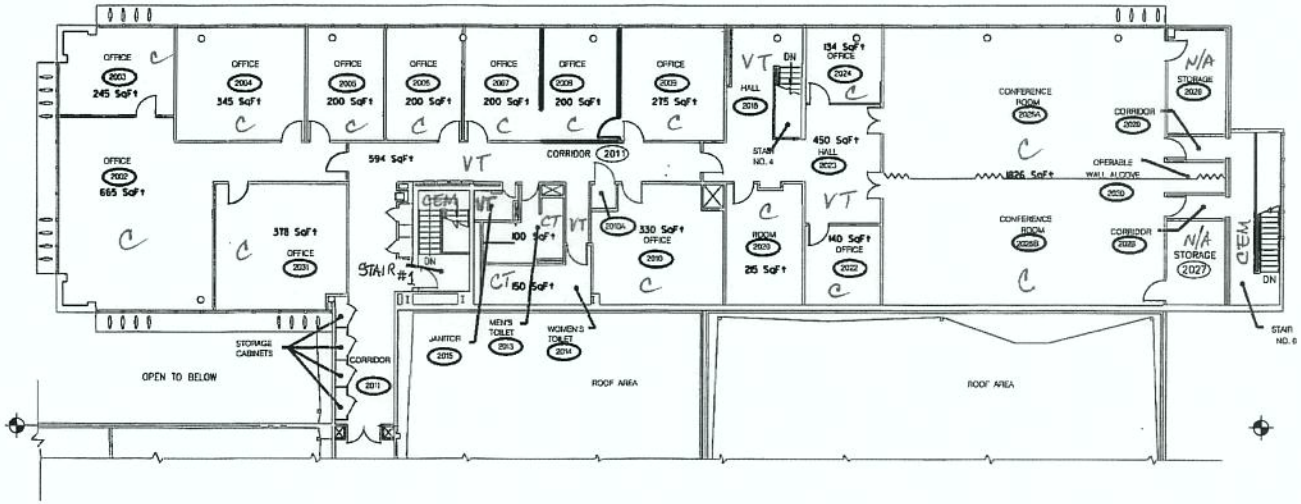

FLOORING:

VT = VINYL TILE
CT = CERAMIC TILE
C = CARPET

N/A = NOT APPLICABLE - NO SERVICE

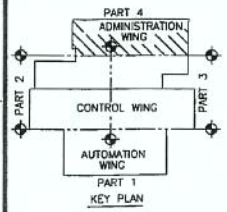

DEPARTMENT OF TRANSPORTATION
FEDERAL AVIATION ADMINISTRATION
SOUTHERN REGION ATLANTA, GA.

ARTCC
ADMINISTRATIVE WING
SECOND FLOOR

MEMPHIS MEMPHIS CENTER TN

ACTIVE

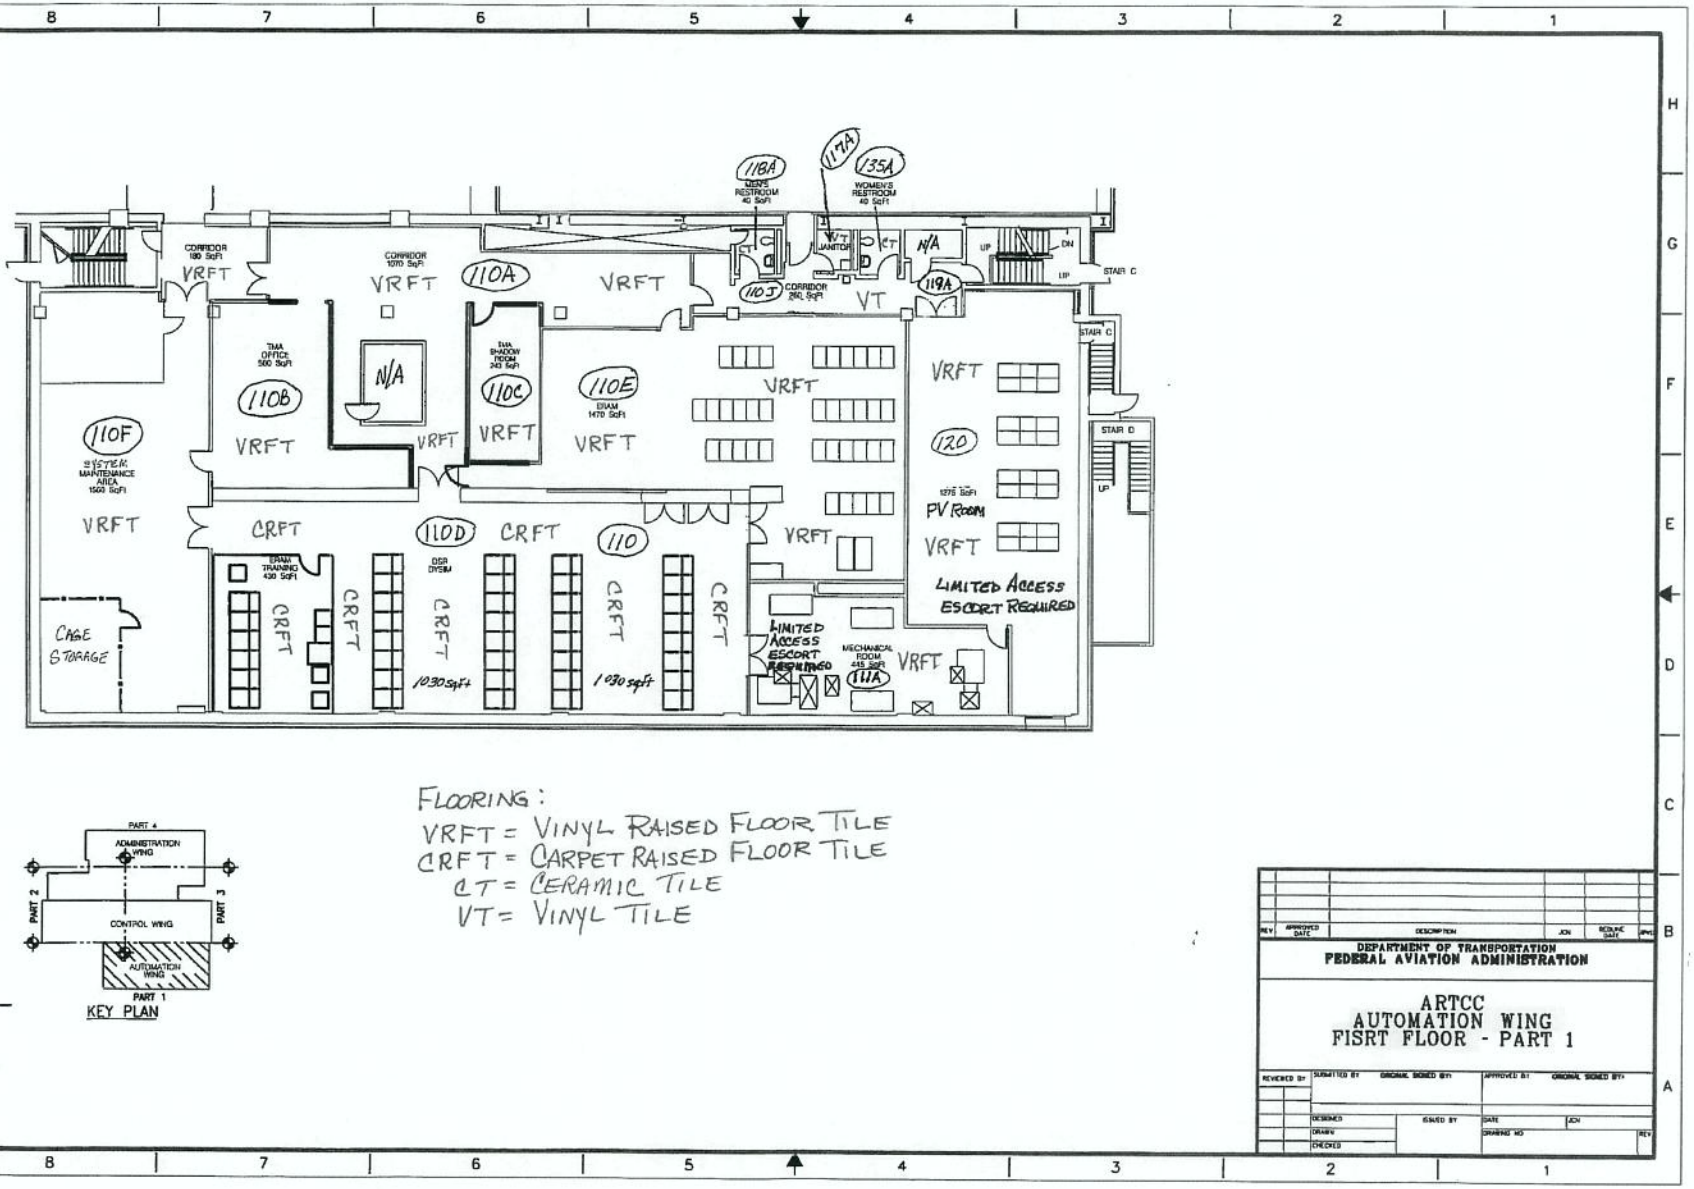

FLOORING:
VRFT = VINYL RAISED FLOOR TILE
CRFT = CARPET RAISED FLOOR TILE
CT = CERAMIC TILE
VT = VINYL TILE

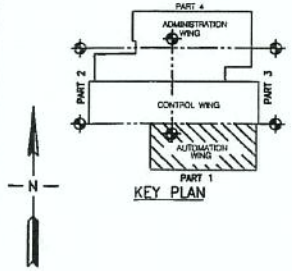

KEY PLAN

DEPARTMENT OF TRANSPORTATION
FEDERAL AVIATION ADMINISTRATION

ARTCC
AUTOMATION WING
FISRT FLOOR - PART 1

AS OF OCTOBER 2010

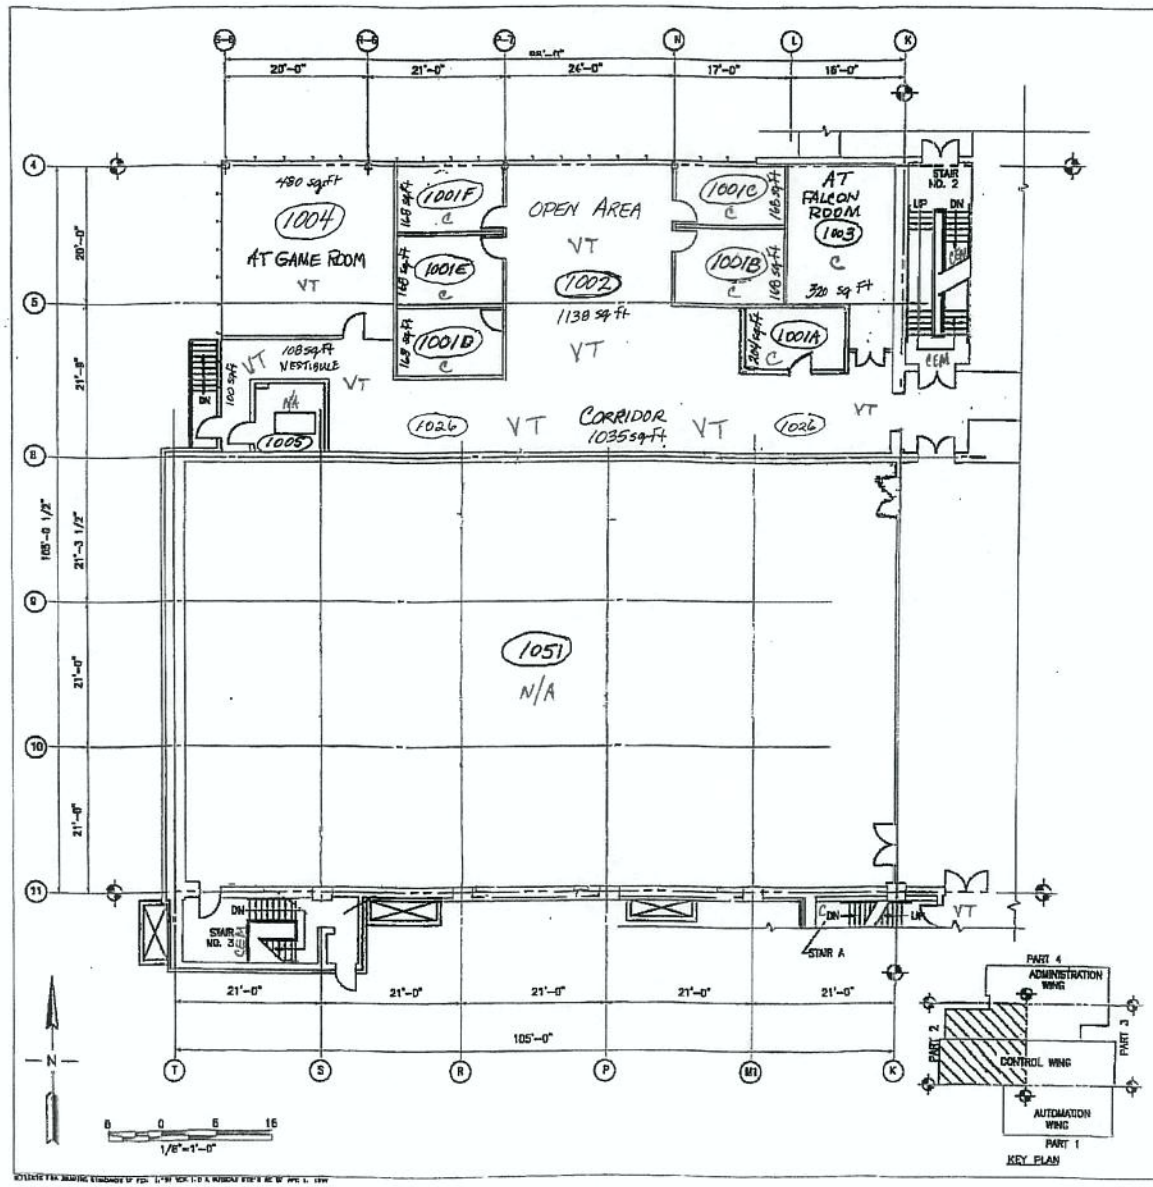

CEM = CEMENT
VT = VINYL TILE
C = CARPET

N/A = NOT APPLICABLE - NO SERVICE

DEPARTMENT OF TRANSPORTATION
FEDERAL AVIATION ADMINISTRATION
SOUTHERN REGION ATLANTA, GEORGIA 30320

ARTCC
BASELINE
FIRST FLOOR PLAN - PART 2
CONTROL WING (WEST)

MEMPHIS ZME TN

AIRWAY FACILITIES DIVISION

SO-D-101713-006 F

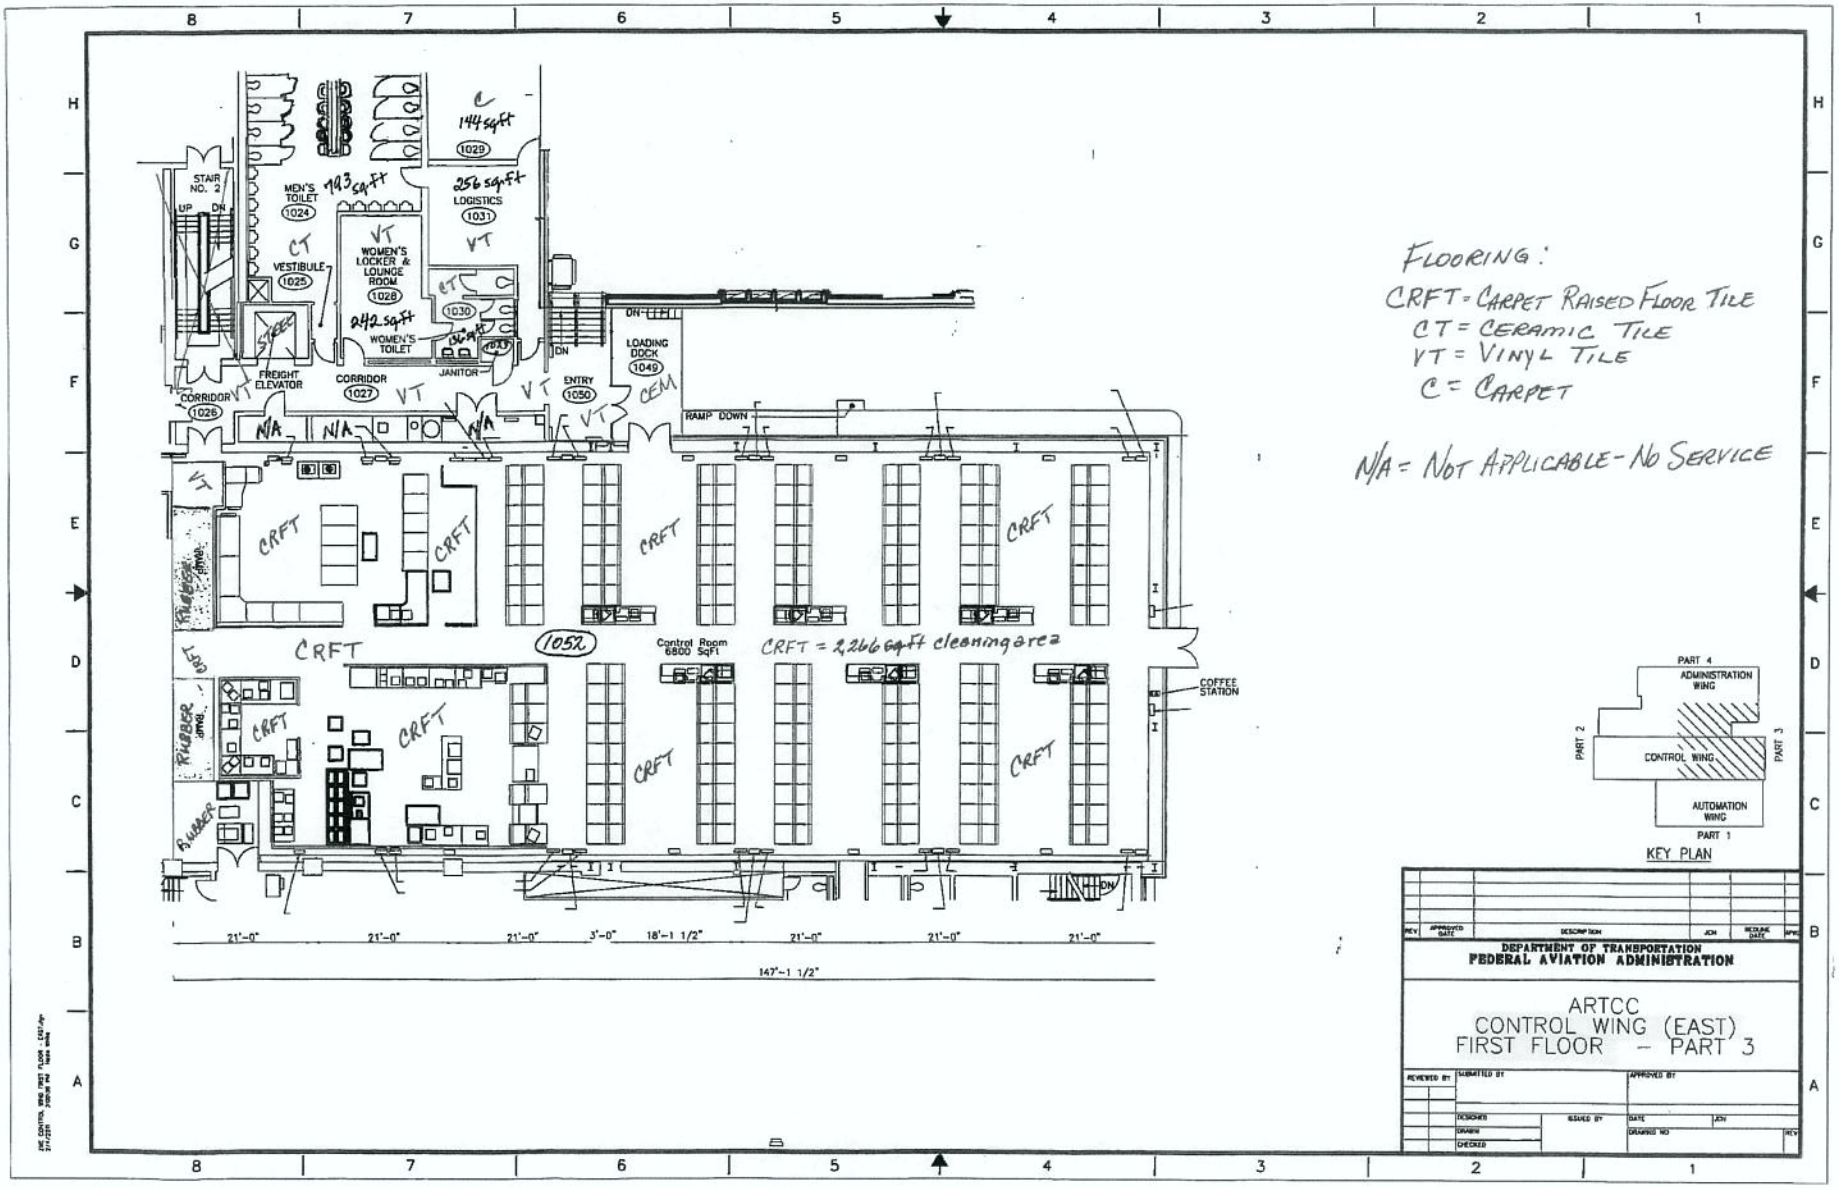

FLOORING:

CRFT = CARPET RAISED FLOOR TILE
CT = CERAMIC TILE
VT = VINYL TILE
C = CARPET

N/A = NOT APPLICABLE - NO SERVICE

KEY PLAN

DEPARTMENT OF TRANSPORTATION
FEDERAL AVIATION ADMINISTRATION

ARTCC
CONTROL WING (EAST)
FIRST FLOOR – PART 3

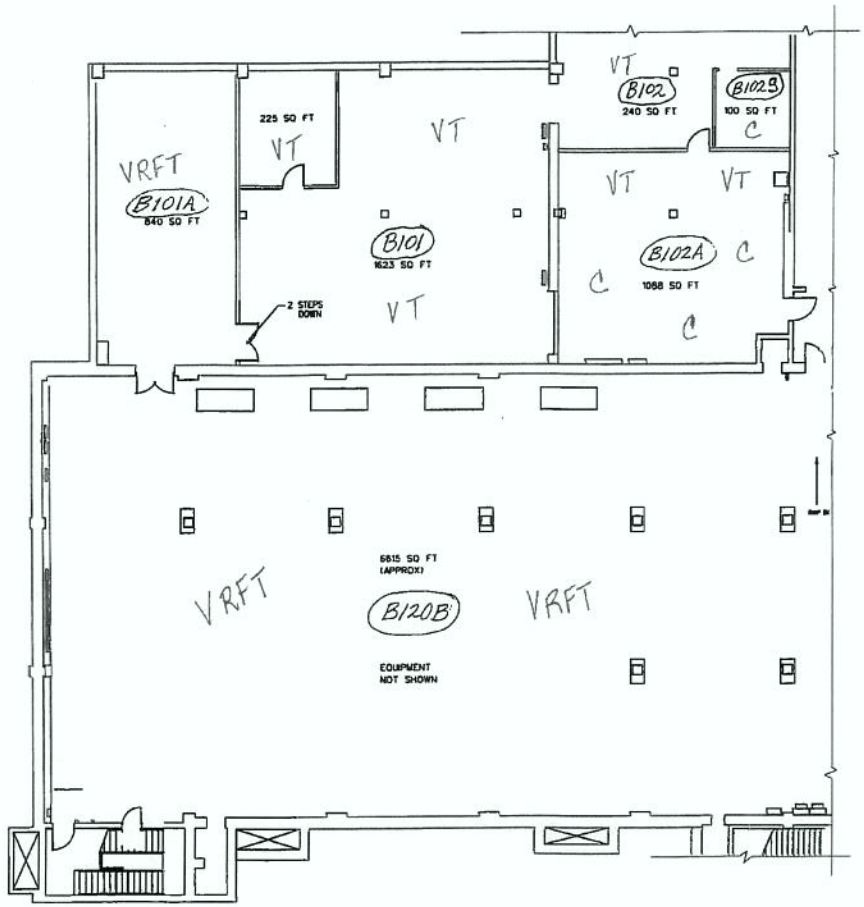

FLOORING:
VRFT = VINYL RAISED FLOOR TILE
VT = VINYL TILE
C = CARPET

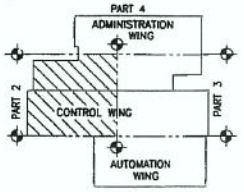

KEY PLAN

N

1/8" = 1'-0"

1 D02 CONTROL WING-WEST PORTION
SCALE: 1/8" = 1'-0"

DEPARTMENT OF TRANSPORTATION
FEDERAL AVIATION ADMINISTRATION

ARTCC
BASEMENT CONTROL WING WEST

MEMPHIS TN

REVIEWED BY | SUBMITTED BY | APPROVED BY
DESIGNED | ISSUED BY | DATE | JCH
DRAWN | DRAWING NO | REV
CHECKED

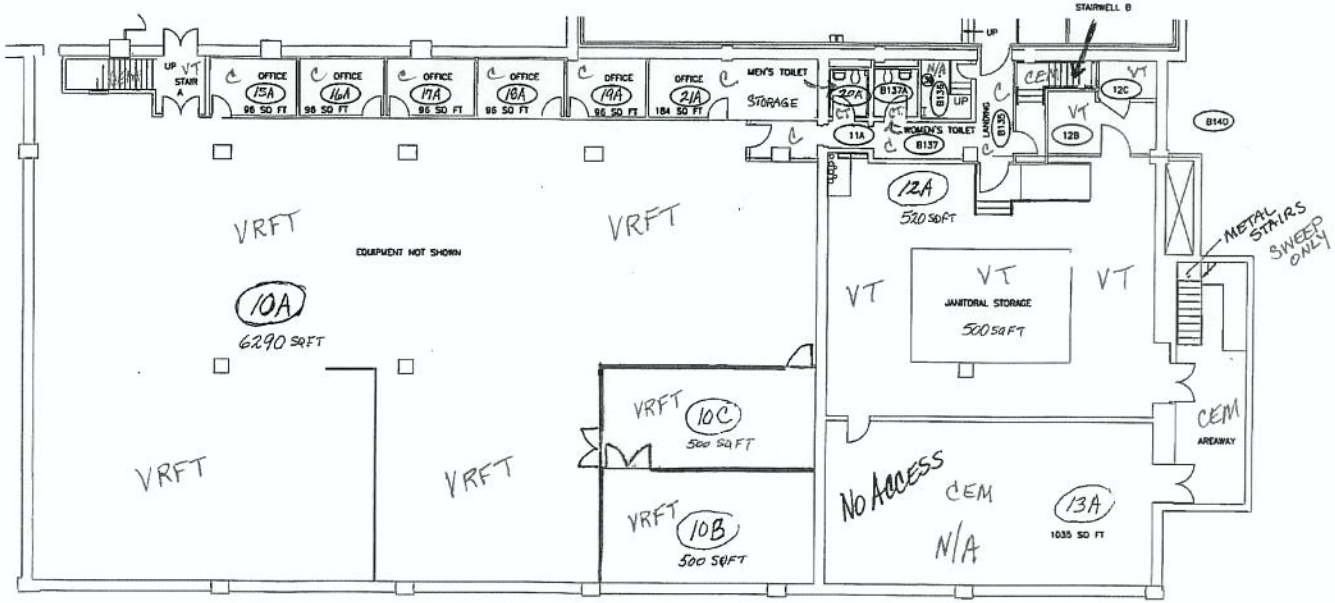

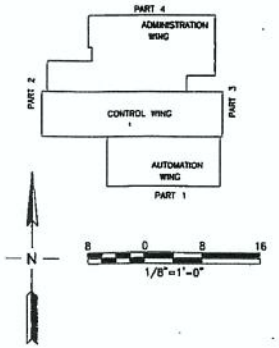

FLOORING:
VRFT = VINYL RAISED FLOOR TILE
CEM = CEMENT
VT = VINYL TILE
C = CARPET

N/A = NOT APPLICABLE - NO SERVICE

REV	APPROVED DATE	DESCRIPTION	JCN	REDLINE DATE	NPMS

DEPARTMENT OF TRANSPORTATION
FEDERAL AVIATION ADMINISTRATION

ARTCC
BASEMENT AUTOMATION WING

MEMPHIS ZME TENNESSEE

REVIEWED BY	SUBMITTED BY	APPROVED BY

DESIGNED	ISSUED BY	DATE	JCN
DRAWN		DRAWING NO	REV
CHECKED			

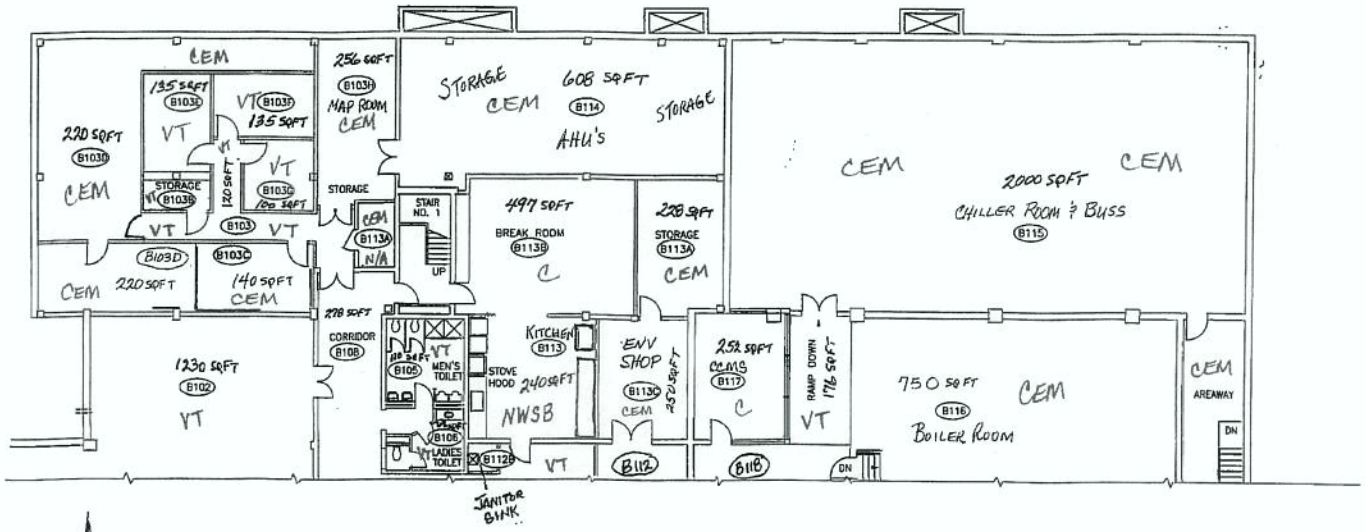

N

8 0 8 16
1/8"=1'-0"

FLOORING:

NWSB = NO WAX-STRIP BUFF (DAMP MOP ONLY)
CEM = CEMENT
VT = VINYL TILE
C = CARPET

N/A = NOT APPLICABLE - NO SERVICE

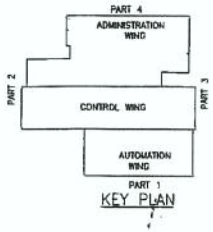

KEY PLAN

REV	APPROVED DATE	DESCRIPTION	JCH	REVISED DATE	APVD

DEPARTMENT OF TRANSPORTATION
FEDERAL AVIATION ADMINISTRATION

ARTCC
BASEMENT ADMINISTRATION WING

MEMPHIS TN

REVIEWED BY	SUBMITTED BY	APPROVED BY
	DESIGNED	ISSUED BY	DATE	JCH
	DRAWN		DRAWING NO	REV
	CHECKED			

DRAWING PRODUCED ON AED 90 AUTOMATION SYSTEM

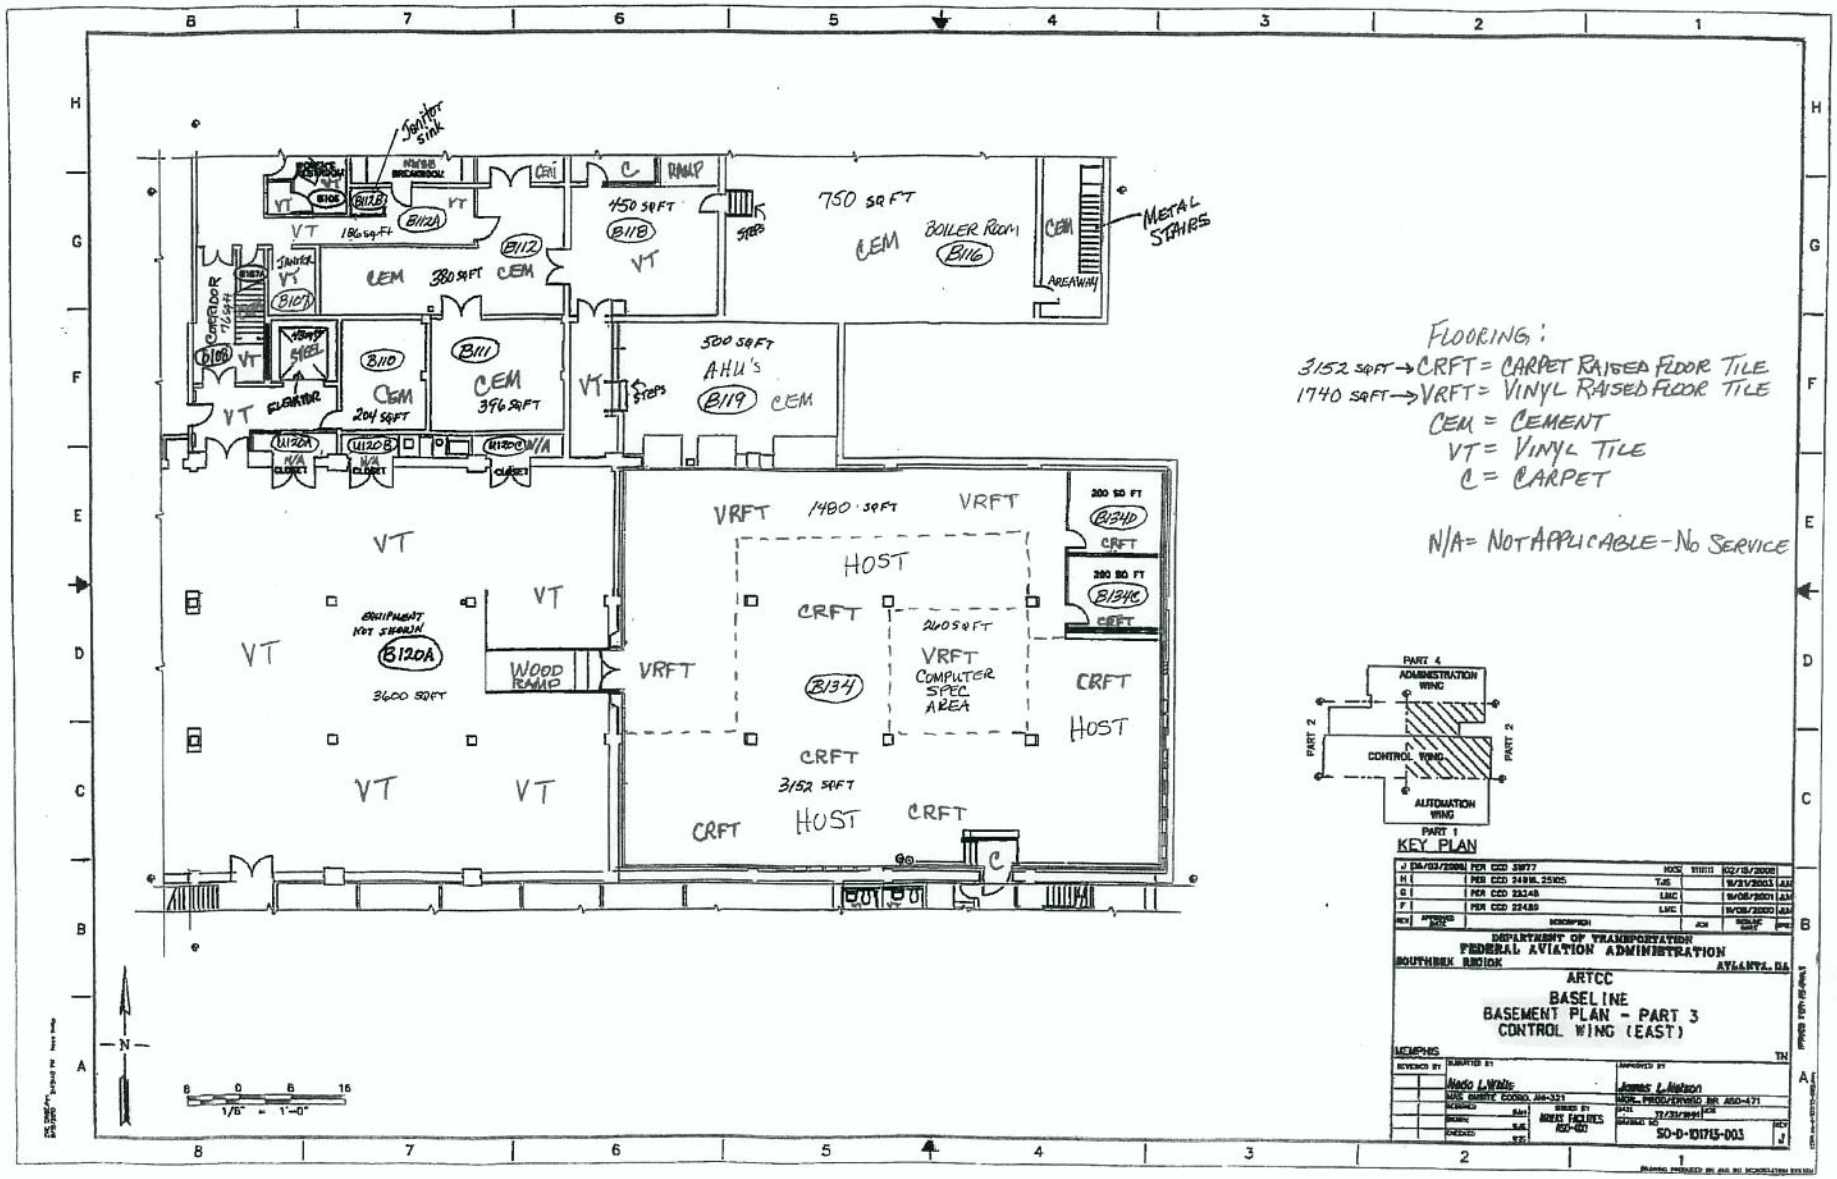

Janitor sink
NWSB BREAKROOM
B112B
B112A
VT
186 sq ft
CEM
380 SQ FT
B112
450 SQ FT
B118
C
RAMP
STEPS
750 SQ FT
BOILER ROOM
B116
METAL STAIRS
AREAWAY
CORRIDOR 76 sq ft
B107
B108
STEEL
ELEVATOR
B110
204 SQ FT
B111
396 SQ FT
500 SQ FT
AHU's
B119
U120A
U120B
U120C
N/A
CLOSET
VRFT
1480 SQ FT
HOST
CRFT
260 SQ FT
VRFT COMPUTER SPEC AREA
B134
B134D
B134C
200 SQ FT
EQUIPMENT NOT SHOWN
B120A
3600 SQ FT
WOOD RAMP
3152 SQ FT
FLOORING:
3152 SQ FT → CRFT = CARPET RAISED FLOOR TILE
1740 SQ FT → VRFT = VINYL RAISED FLOOR TILE
CEM = CEMENT
VT = VINYL TILE
C = CARPET
N/A = NOT APPLICABLE - NO SERVICE
PART 4
ADMINISTRATION WING
PART 2
CONTROL WING
AUTOMATION WING
PART 1
KEY PLAN
DEPARTMENT OF TRANSPORTATION
FEDERAL AVIATION ADMINISTRATION
SOUTHERN REGION
ATLANTA, GA
ARTCC
BASELINE
BASEMENT PLAN - PART 3
CONTROL WING (EAST)
MEMPHIS
TN
Nado L. White
James L. Nelson
AREAS FACILITIES ASO-400
SO-D-101715-003
1/8" = 1'-0"

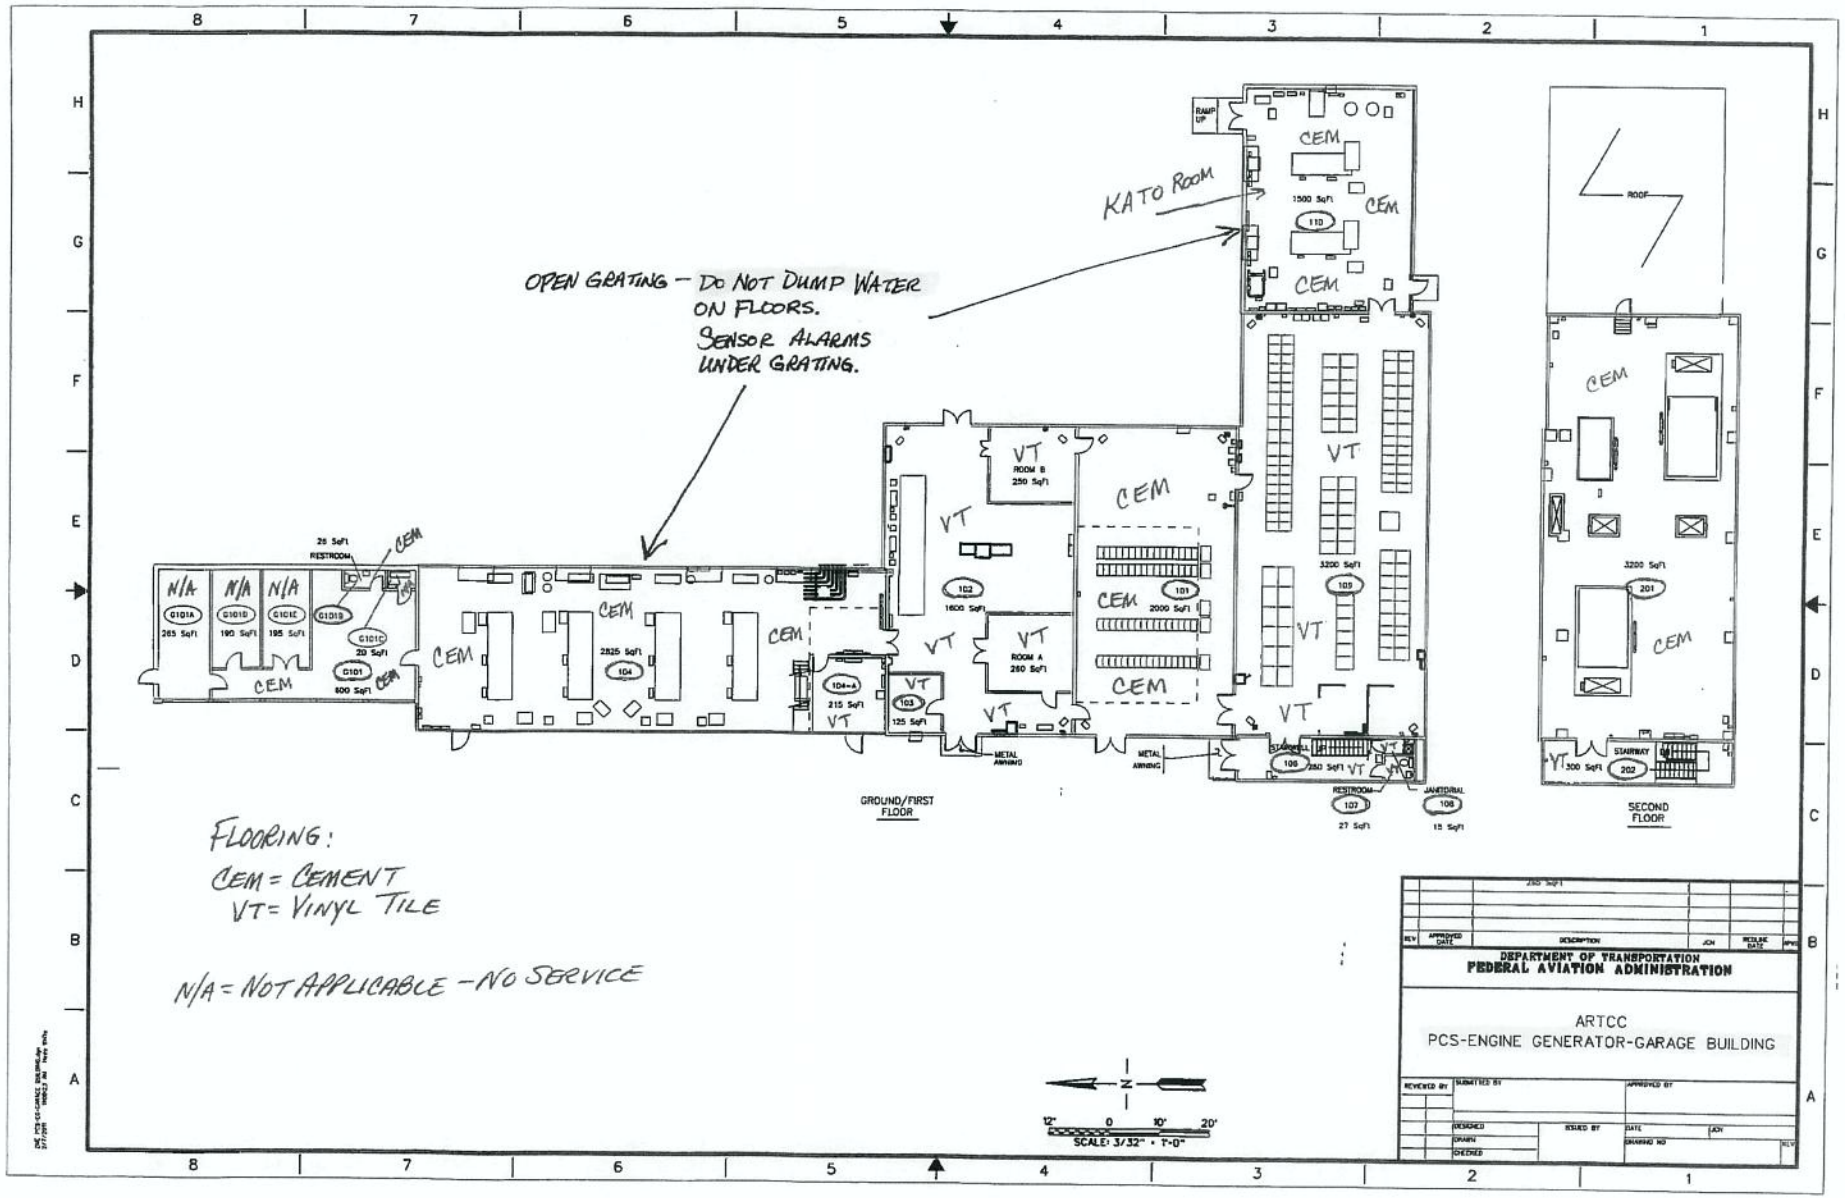

FLOORING:

CEM = CEMENT

VT = VINYL TILE

N/A = NOT APPLICABLE – NO SERVICE

DEPARTMENT OF TRANSPORTATION
FEDERAL AVIATION ADMINISTRATION

ARTCC
PCS-ENGINE GENERATOR-GARAGE BUILDING

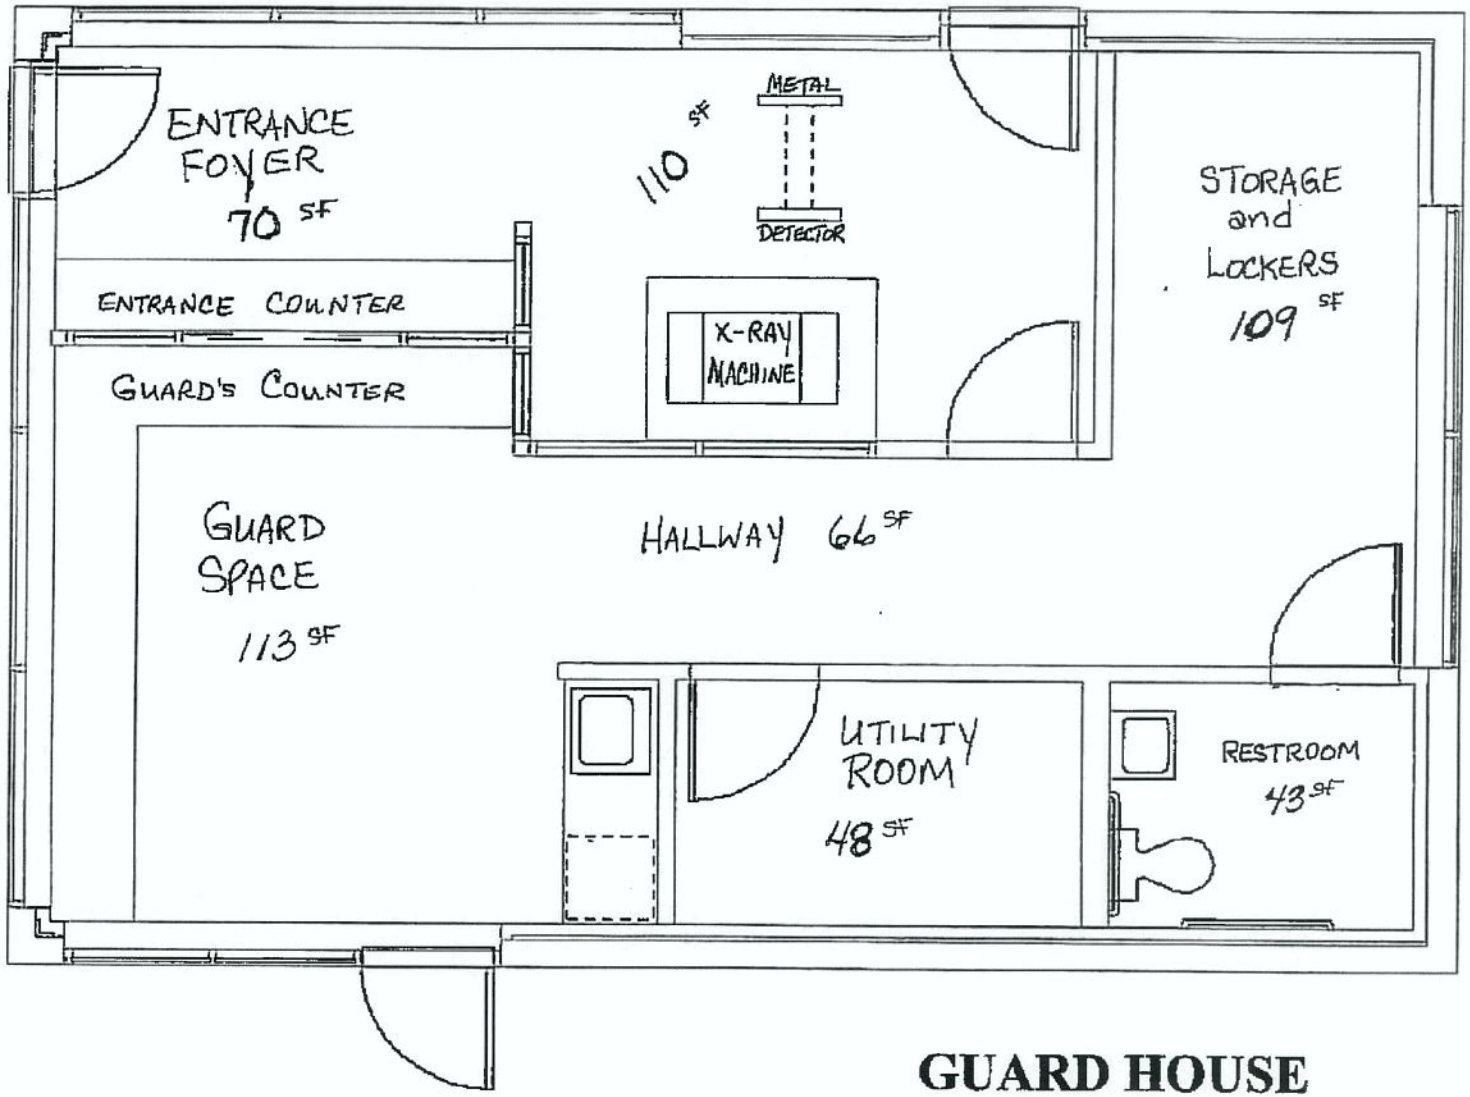

N

S

FLOORING: ALL VINYL
TOTAL SQUARE FEET: 559

GUARD HOUSE

FEDERAL AVIATION ADMINISTRATION
AIR ROUTE TRAFFIC CONTROL CENTER
3229 DEMOCRAT ROAD
MEMPHIS, TN 38118

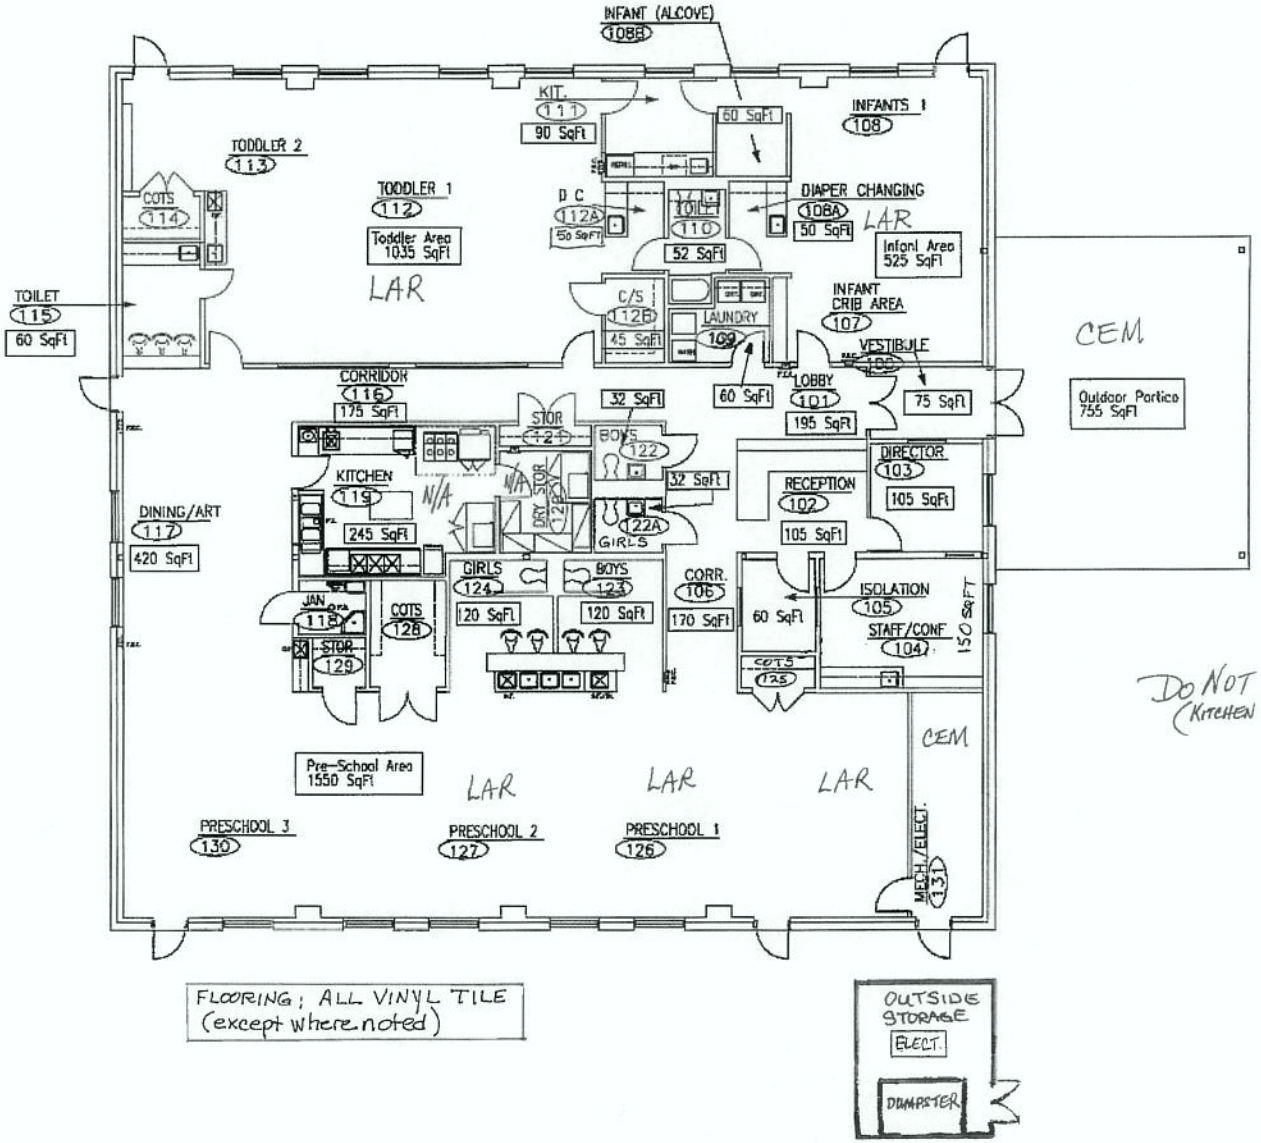

FLOORING: ALL VINYL TILE (except where noted)

OUTSIDE STORAGE
ELECT.
DUMPSTER

FLOORING:
LAR = LARGE AREA RUGS
CEM = CEMENT
VT = VINYL TILE

N/A = NOT APPLICABLE - NO SERVICE

DO NOT CLEAN KITCHEN OR DRY STORAGE
(KITCHEN PERSONNEL ARE RESPONSIBLE)

DEPARTMENT OF TRANSPORTATION
FEDERAL AVIATION ADMINISTRATION
SOUTHERN REGION — ATLANTA, GEORGIA 30320

ARTCC
CHILD CARE CENTER

MEMPHIS — ARTCC — TENNESSEE

AIRWAY FACILITIES DIVISION

DATE -07/07/95

ZME 4004-005