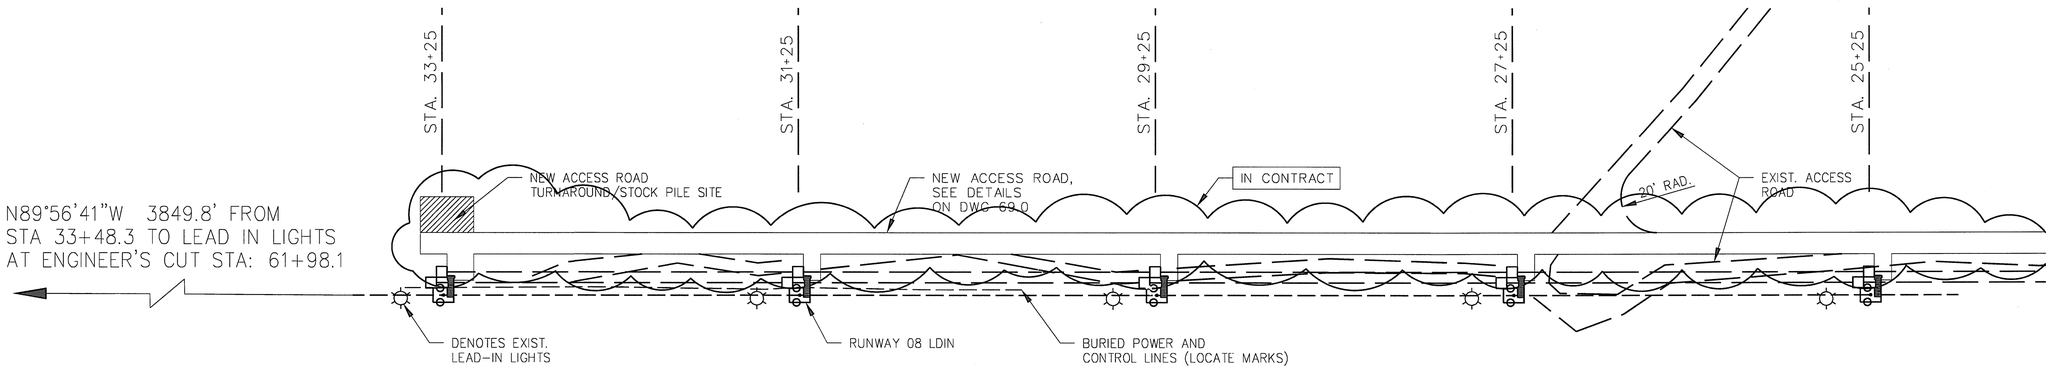

LDIN 08 LIGHTS PLAN VIEW

SCALE: HORZ. 1" = 40'

DENOTES EXISTING LEAD-IN LIGHTS

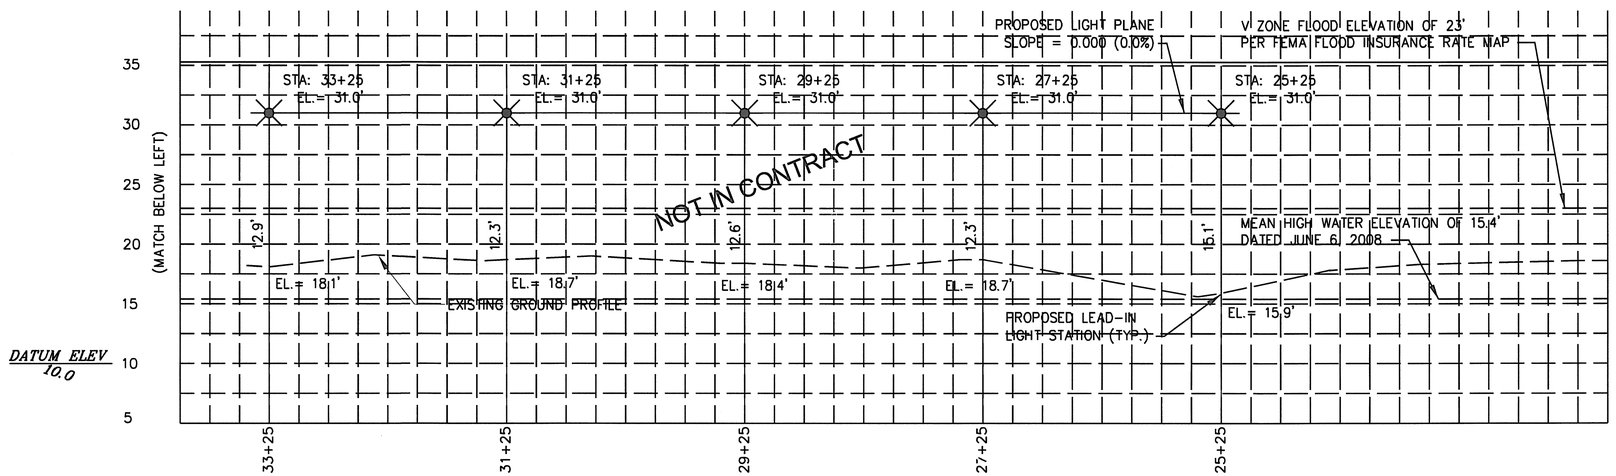

LDIN 08 LIGHT PLANE PROFILE VIEW

FLASHING LIGHTS

STATION	25+25	27+25	29+25	31+25	33+25
TYPE OF SUPPORT	RIGID	RIGID	RIGID	RIGID	RIGID
APPROX. STATION HEIGHT	5.0'	5.0'	5.0'	5.0'	5.0'
ELEV. LIGHT PLANE	31.0'	31.0'	31.0'	31.0'	31.0'
WALKING PLATFORM ELEV.	26.0'	26.0'	26.0'	26.0'	26.0'
AIMING ANGLE	6.0	6.0	6.0	6.0	6.0

NOT IN CONTRACT

LEGEND

✳ FLASHING LIGHT BAR

AIRPORT DATA	
JUNEAU INTERNATIONAL AIRPORT, JUNEAU, ALASKA (JNU)	
JUNEAU GROUND CONTROL	121.9 khz
JUNEAU TOWER	118.7 khz
POWER COMPANY	ALASKA ELECTRIC LIGHT AND POWER

NOTES:

1. ~~THE EXISTING LDIN SYSTEM SHALL REMAIN OPERATIONAL WHILE THE NEW LDIN IS BEING CONSTRUCTED.~~
2. ~~THE NEW LDIN SYSTEM WILL BE COMMISSIONED IN SUMMER 2012.~~
3. ~~ONCE THE NEW LDIN SYSTEM IS COMMISSIONED, THE OLD LDIN SYSTEM SHALL BE COMPLETELY DEMOLISHED AND SITE RESTORED.~~
4. THE CONTRACTOR SHALL REMOVE SOD FROM THE NEW ROAD TEMPLATE AND WILL LAY THIS SOD IN THOSE PORTIONS OF THE OLD ACCESS ROAD THAT WILL NOT BE USED AS THE NEW ACCESS ROAD AS PER THE SPECIFICATIONS.
5. ALL STOCK PILE SITES SHALL BE COMPLETELY RESTORED AT THE END OF THE PROJECT.
6. DO NOT CUT MASTS UNTIL FINAL FINISHED PLATFORM ELEVATIONS ARE SURVEYED.

FOR OFFICIAL USE ONLY
PUBLIC AVAILABILITY TO BE DETERMINED UNDER 5 USC 552

REV	APPROVED DATE	DESCRIPTION	JCN	REDLINE DATE	APVD

DEPARTMENT OF TRANSPORTATION
FEDERAL AVIATION ADMINISTRATION
ATO - TECHNICAL OPERATIONS WESTERN SERVICE AREA

LDIN
RWY 08 - THE FLATS
REPLACE LDIN
PLAN AND PROFILE

JUNEAU JUNEAU INTERNATIONAL AIRPORT AK

REVIEWED BY
SUBMITTED BY
APPROVED BY: Morris S. Clark
PROJECT ENGINEER
MGR: CONSTRUCTION/INSTALLATION
DESIGNED
DRAWN
CHECKED
ISSUED BY ENGINEERING SERVICES NAVAIDS
DATE 11/14/2011 JCN 1004011
DRAWING NO JNU-D-LDIN-C201 REV

ISSUED FOR: CONSTRUCTION

jnu-d-ldin-c201.dgn 11/8/2011 3:22:38 PM loridivona

DWG. 40.0-L