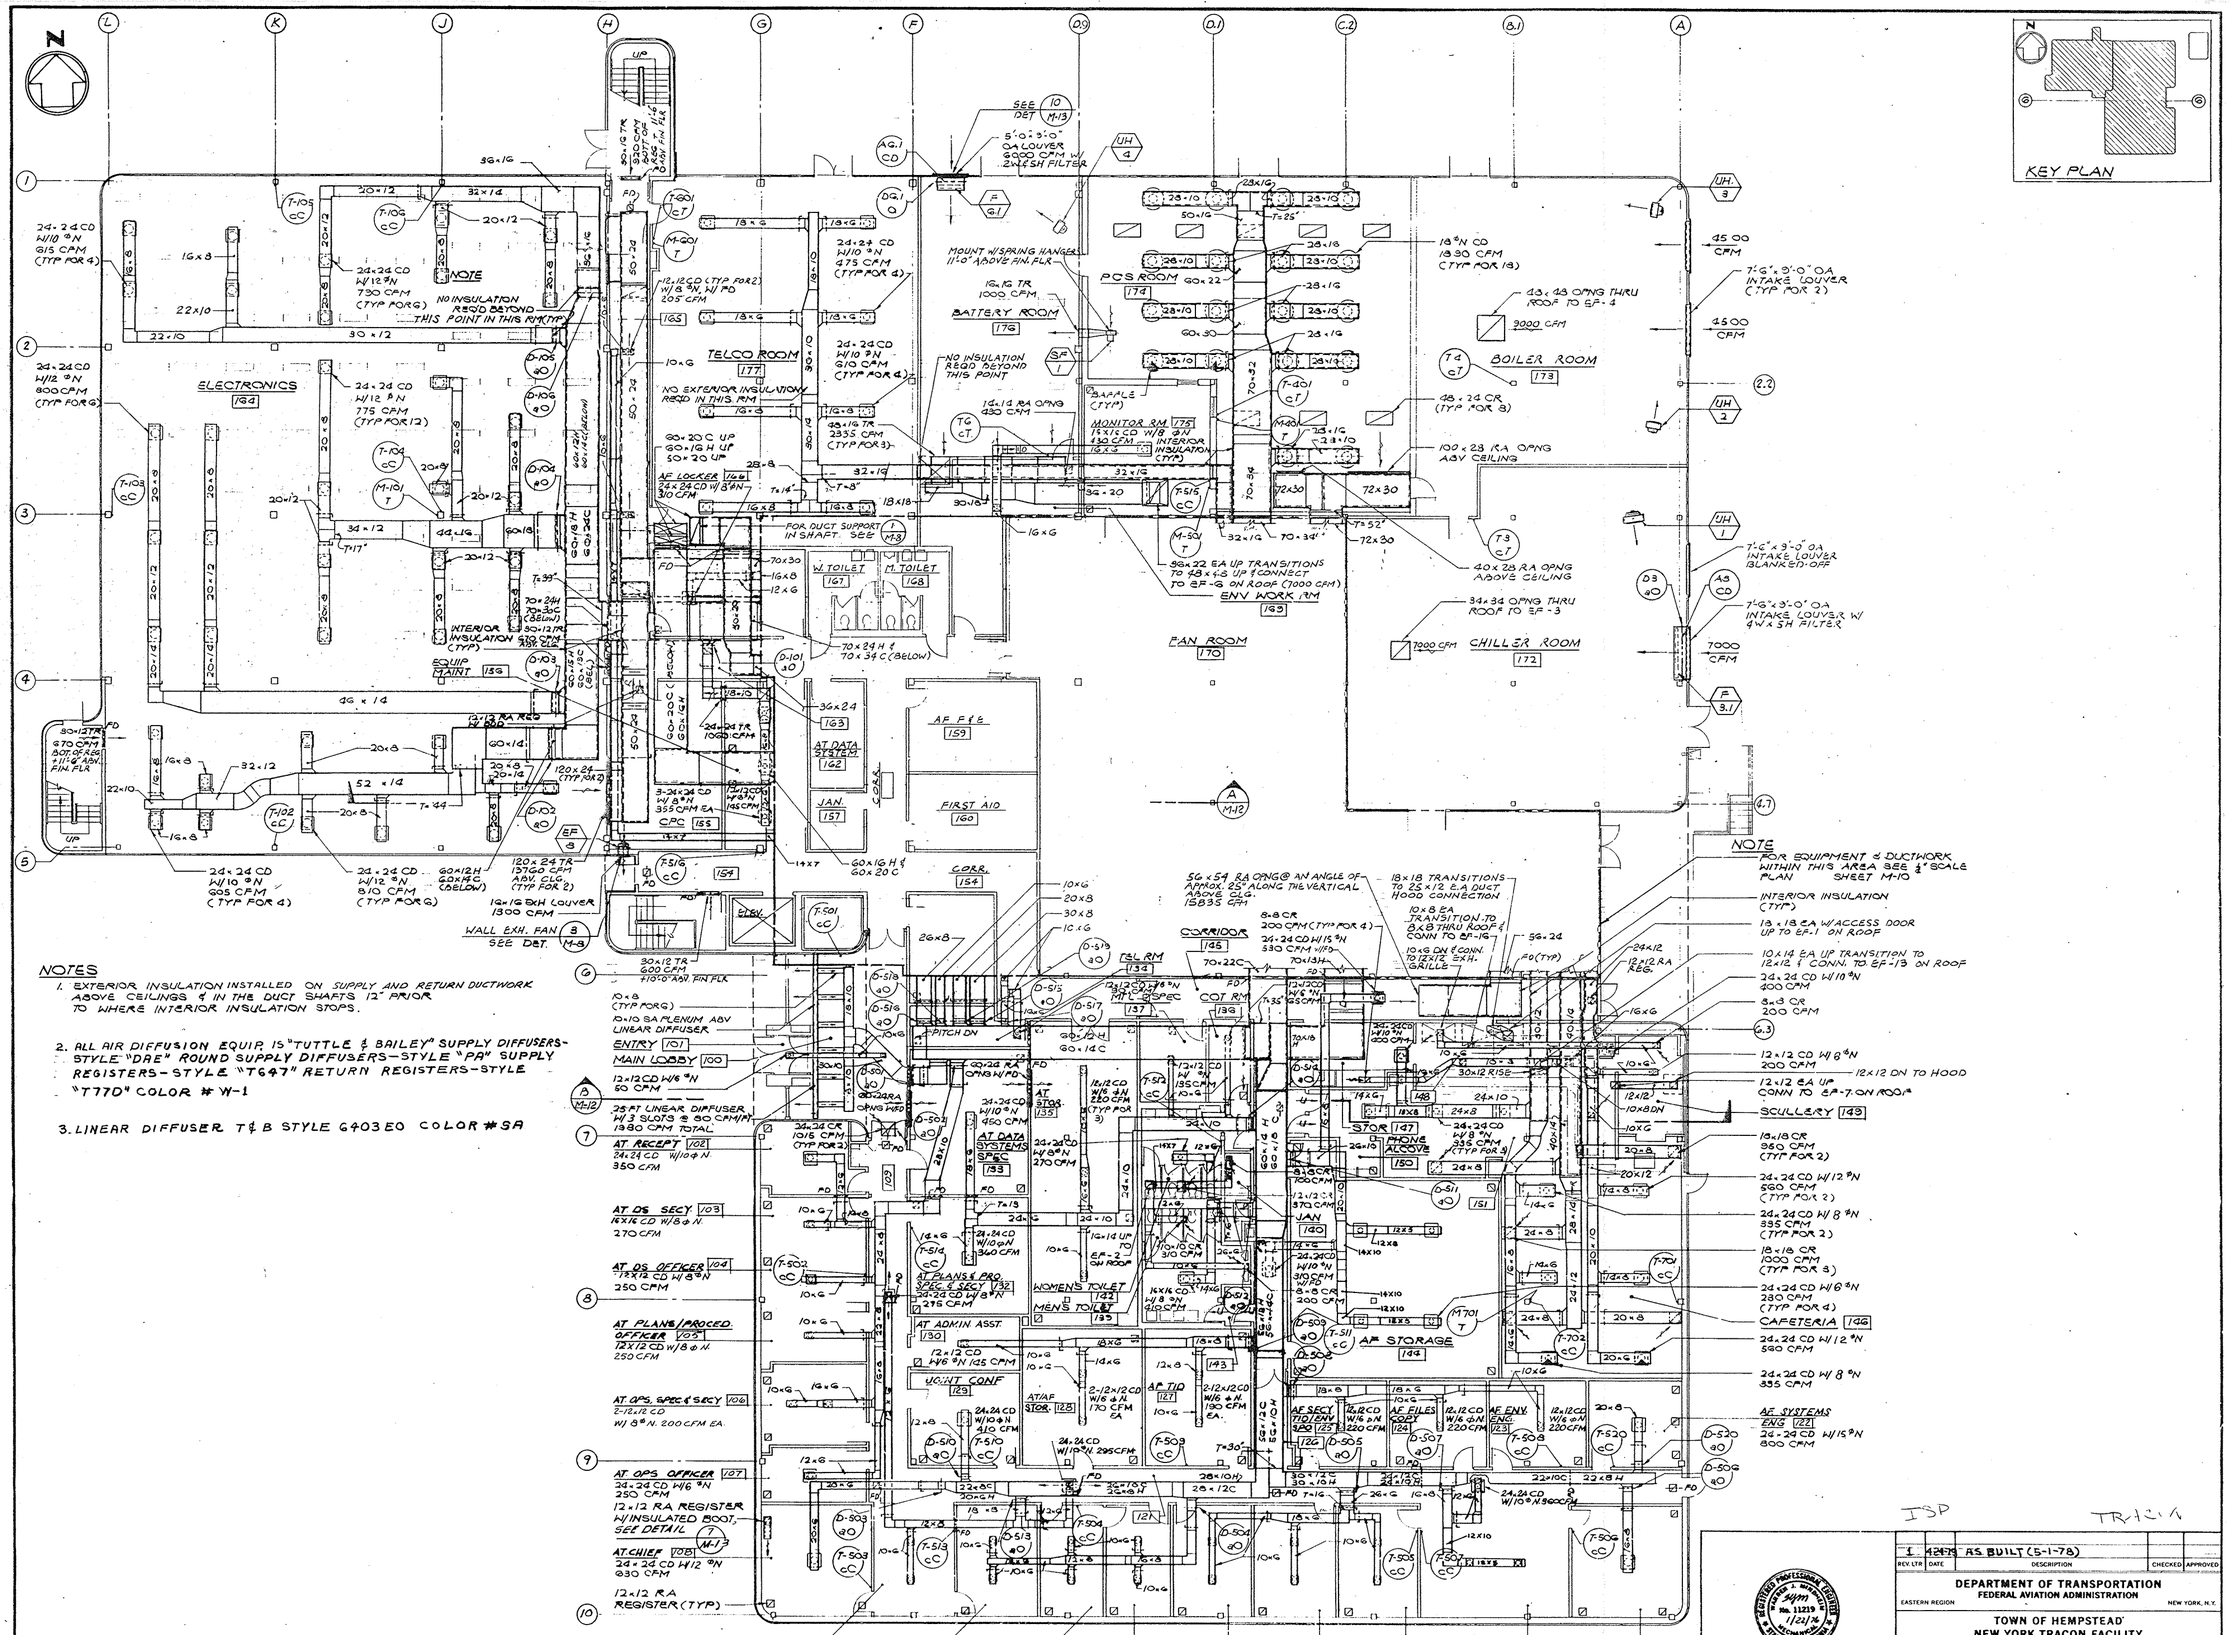
KEY PLAN
ELECTRONICS 164
TELCO ROOM 177
BATTERY ROOM 176
POS ROOM 174
BOILER ROOM 173
CHILLER ROOM 172
FAN ROOM 170
ENV WORK RM 169
W. TOILET 167
M. TOILET 168
AF F&E 159
FIRST AID 160
AT DATA SYSTEM 162
JAN 157
CPC 155
CORR. 154
CORRIDOR 145
TEL RM 134
COT RM 136
STOR 147
PHONE ALCOVE 150
JAN 140
AF STORAGE 144
AT STOR 135
AT DATA SYSTEMS SPEC 133
WOMENS TOILET 142
MENS TOILET 139
AT ADMIN ASST 130
JOINT CONF 129
AT/AF STOR 128
AF TID 127
AF SECY TID/ENV SPO 125
AF FILES COPY 124
AF ENV ENG 123
AF SYSTEMS ENG 122
CAFETERIA 146
SCULLERY 149
ENTRY 101
MAIN LOBBY 100
AT DS SECY 103
AT DS OFFICER 104
AT PLANS/PROCED. OFFICER 105
AT OPS. SPEC & SECY 106
AT OPS OFFICER 107
AT CHIEF 108
AT CHIEF & SECY & FILES 112
AT DEPUTY CHIEF 113
AT EPDO OFFICER 114
AT EPDO SECY 115
AF SPO/SPS 116
AF EPDO & TRAINING 117
AF ASST CHIEF 118
AF SECY CLERK STENO 119
AF CHIEF 120
NOTE
FOR EQUIPMENT & DUCTWORK WITHIN THIS AREA SEE 1/4" SCALE PLAN SHEET M-10
NOTES
1. EXTERIOR INSULATION INSTALLED ON SUPPLY AND RETURN DUCTWORK ABOVE CEILINGS & IN THE DUCT SHAFTS 12" PRIOR TO WHERE INTERIOR INSULATION STOPS.
2. ALL AIR DIFFUSION EQUIP. IS "TUTTLE & BAILEY" SUPPLY DIFFUSERS-STYLE "DAE" ROUND SUPPLY DIFFUSERS-STYLE "PA" SUPPLY REGISTERS-STYLE "T647" RETURN REGISTERS-STYLE "T770" COLOR # W-1
3. LINEAR DIFFUSER T&B STYLE 6403EO COLOR #SA
FIRST FLOOR PLAN
1/8" = 1'-0"
ISP
TRACON
1 4-24-76 AS BUILT (5-1-78)
REV. LTR DATE DESCRIPTION CHECKED APPROVED
DEPARTMENT OF TRANSPORTATION
FEDERAL AVIATION ADMINISTRATION
EASTERN REGION NEW YORK, N.Y.
TOWN OF HEMPSTEAD
NEW YORK TRACON FACILITY
FIRST FLOOR PLAN
KDG-PARSONS
ARCHITECTS-ENGINEERS
PASADENA, CALIFORNIA
SUBMITTED BY
DATE 2/23/76
SUBMITTED BY R Halpern
APPROVED BY
DATE 2-23-76
ISSUED BY ENGINEERING BRANCH AIRWAY FACILITIES DIVISION
DRAWING NO. AEA-E-26550-186
REV. LTR. R