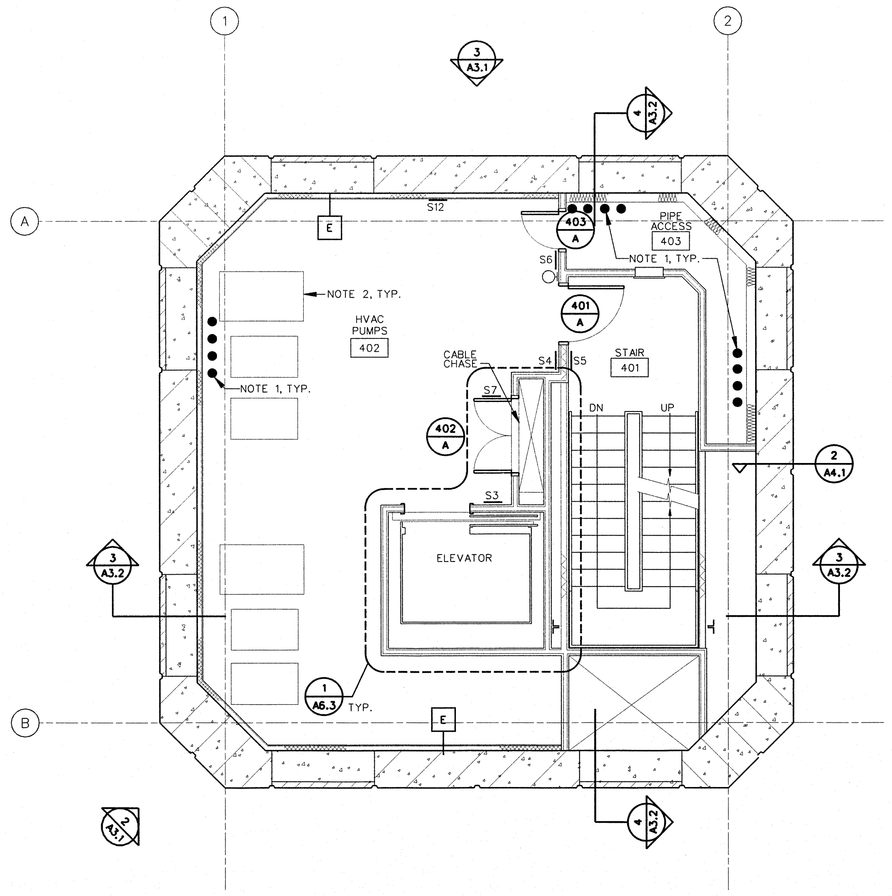

4 A010 A010 LEVEL 4
SCALE: 1/4" = 1'-0"

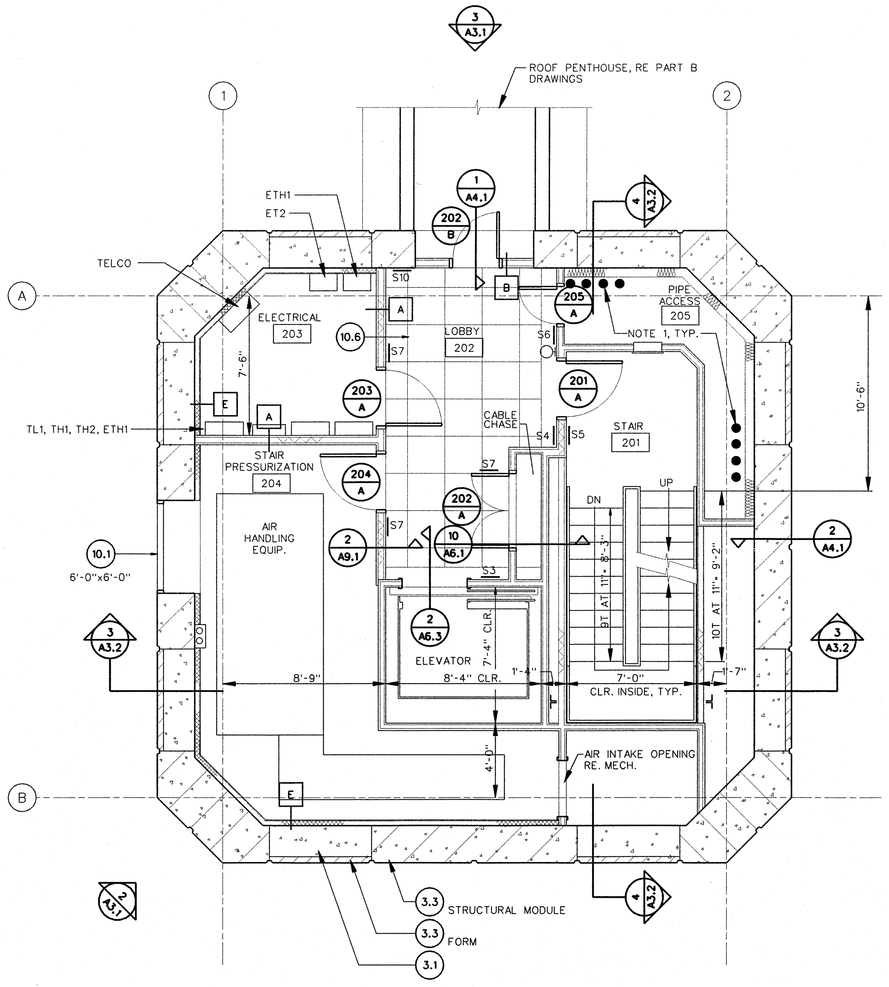

2 A010 A010 LEVEL 2
SCALE: 1/4" = 1'-0"

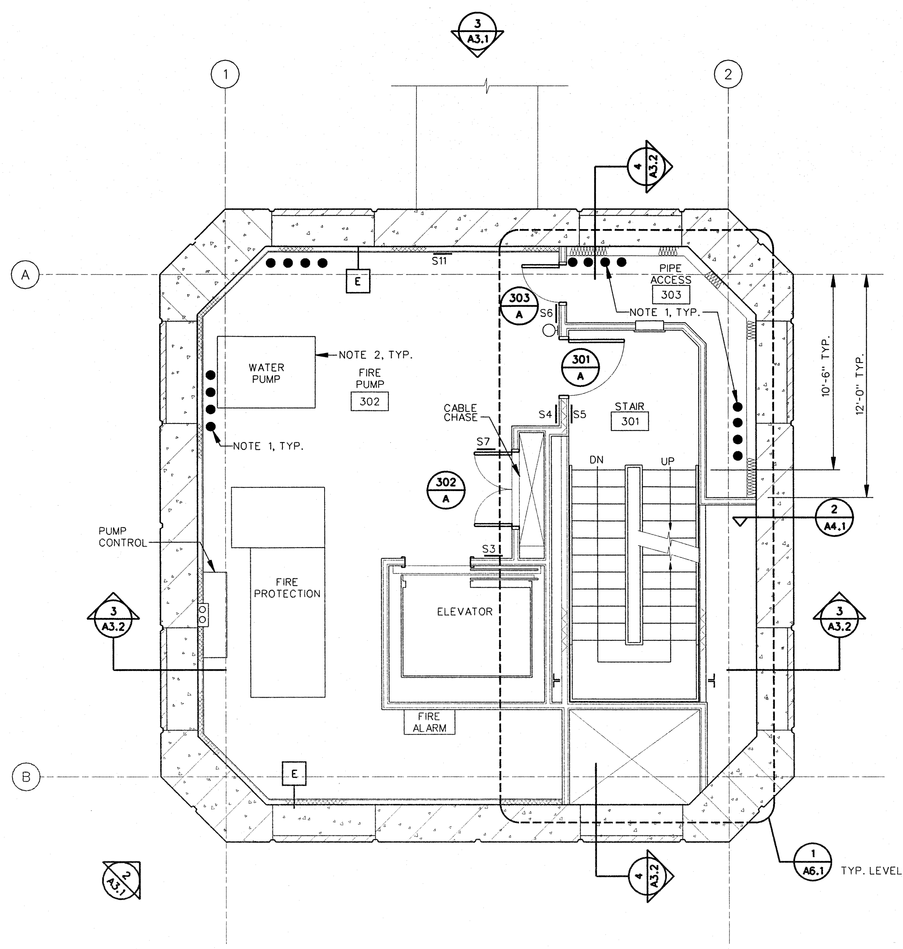

3 A010 A010 LEVEL 3
SCALE: 1/4" = 1'-0"

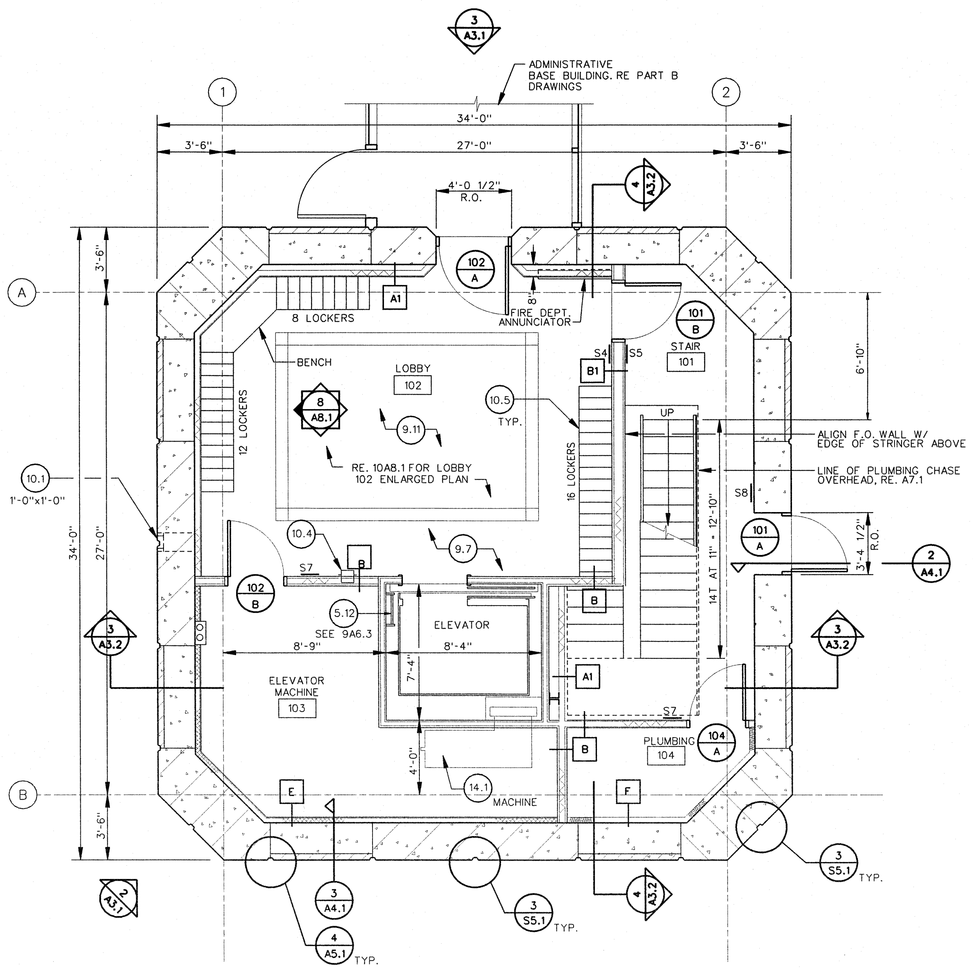

1 A010 A010 GROUND LEVEL
SCALE: 1/4" = 1'-0"

KEYNOTES

DIVISION 3

3.1 CAST-IN-PLACE CONCRETE
3.2 CONCRETE FILL
3.3 PRECAST CONCRETE
3.4 GROUT
3.5 DRAINABLE FILL

DIVISION 5

5.1 STEEL WIDE FLANGE
5.2 STEEL CHANNEL
5.3 STEEL TEE
5.4 STEEL ANGLE
5.5 STEEL PLATE
5.6 STEEL TUBE
5.7 STEEL ROD
5.8 STEEL PIPE
5.9 METAL DECK
5.10 DECK EDGE FORM
5.11 SHEET METAL
5.12 METAL LADDER
5.13 METAL GUARDRAIL
5.14 OPEN WEB STEEL JOIST
5.15 EXPANSION JOINT ASSEMBLY

DIVISION 6

6.1 WOOD BLOCKING
6.2 SHIM
6.3 PLYWOOD
6.4 PLASTIC LAMINATE
6.5 HARDWOOD TRIM
6.6 HARDWOOD VENEER

DIVISION 7

7.1 VAPOR BARRIER
7.2 BATT INSULATION
7.3 RIGID INSULATION
7.4 FLUID APPLIED WATERPROOFING
7.5 MEMBRANE ROOFING
7.6 TRAFFIC COATING
7.7 ROOF WALKWAY PADS
7.8 ROOF HATCH
7.9 PREFORMED METAL COPING
7.10 METAL FLASHING
7.11 PROFILED METAL PANEL
7.12 INSULATED METAL PANEL
7.13 METAL GLAZING PANEL
7.14 JOINT FILLER
7.15 SEALANT
7.16 CEMENTITIOUS FIREPROOFING
7.17 FIRESTOPPING

DIVISION 8

8.1 STEEL DOOR
8.2 STEEL FRAME
8.3 ACCESS DOOR
8.4 ALUMINUM CURTAIN WALL
8.5 INSULATED GLAZING
8.6 TEMPERED GLASS
8.7 COILING OVERHEAD DOOR

DIVISION 9

9.1 METAL STUD
9.2 DEFLECTION TRACK
9.3 HAT CHANNEL
9.4 5/8" GYPSUM BOARD
9.5 1" GYPSUM SHAFT-LINER
9.6 GWB CONTROL JOINT
9.7 CERAMIC TILE
9.8 SUSPENDED ACOUSTICAL TILE CELING
9.9 PAINT
9.10 RESILIENT FLOORING
9.11 CARPET

DIVISION 10

10.1 METAL LOUVER
10.2 TOILET PARTITION
10.3 FIRE VALVE CABINET
10.4 FIRE EXTINGUISHER
10.5 METAL LOCKERS
10.6 RAISED ACCESS FLOOR

DIVISION 12

12.1 WINDOW SHADES
12.2 WINDOW BLINDS
12.3 FOOT GRILLE

DIVISION 13

13.1 MICROWAVE TRANSPARENT FABRIC

DIVISION 14

14.1 GEARED TRACTION ELEVATOR
14.2 MOTORIZED HOIST

DIVISION 15

15.1 ROOF DRAIN
15.2 FLOOR DRAIN
15.3 LINEAR DIFFUSER
15.4 HVAC DIFFUSER, GRILLE OR REGISTER
15.5 DRINKING FOUNTAIN
15.6 MOTORIZED DAMPER
15.7 FIN-TUBE RADIATOR
15.8 ROOF-TOP HVAC EQUIPMENT

DIVISION 16

16.1 LIGHT FIXTURE
16.2 AIR TERMINAL
16.3 ANTENNA MOUNT
16.4 OBSTRUCTION LIGHT
16.5 RACEWAY

DRAWING NOTES

1. PIPE OR CONDUIT SLEEVES THROUGH FLOOR: ALL OPENINGS TO BE FIRESTOPPED. SEE MECHANICAL, PLUMBING OR ELECTRICAL DRAWINGS FOR LOCATIONS.
2. CONCRETE HOUSEKEEPING PAD: SEE MECHANICAL, PLUMBING OR ELECTRICAL DRAWINGS FOR APPROXIMATE SIZES AND LOCATIONS. SEE STRUCTURAL DRAWINGS FOR CONSTRUCTION DETAILS.

THIS DRAWING SUPERSEDES DRAWING NME-601-41518-A2.1, REV A, DATED 07/10/1996

REV	DATE	DESCRIPTION	JCN	REDLINE DATE	APVD
A	9-21-05	ESTABLISH BASELINE PER CCD: 23021		9-21-05	

DEPARTMENT OF TRANSPORTATION
FEDERAL AVIATION ADMINISTRATION
NORTHWEST MOUNTAIN REGION — SEATTLE, WA

ATCT

LEVELS 1 TO 4 FLOOR PLANS

PORTLAND — PORTLAND INTERNATIONAL AIRPORT — OR

CONFIGURATION MANAGEMENT — TECHNICAL OPERATIONS — INTEGRITY — SYSTEM STABILITY — RELIABILITY

Georgia Van Pelt 9-21-05
IT MANAGER — DATE

THIS FACILITY IS UNDER CONFIGURATION CONTROL. CHANGES REQUIRE AN AUTHORIZING CCD.

4' 0 4' 8'
SCALE: 1/4" = 1'-0"

REVIEWED BY	
SUBMITTED BY	Georgia Van Pelt
APPROVED BY	Susan Powers
PROJECT ENGINEER, ANM-472	SUPERVISOR, ANM-472
DESIGNED SSC	ISSUED BY AIRWAY FACILITIES ANM-400
DATE 9/23/05	JCN
DRAWN DVP	DRAWING NO PDX-E-ATCT-A010-BL
REV A	
CHECKED BAD	

THIS DRAWING PRODUCED ON THE NORTHWEST MOUNTAIN REGIONAL OFFICE MICROSTATION SYSTEM